

Addendum 2

Project: **WJUSD ADULT ED CTE CLASSROOM RENOVATIONS**
Project Number: **21-W04-01**

Owner: **Woodland Joint USD**

A/E: **Synthesis Partners, LLC**
PO Box 1900
Yuba City, CA 95992

This Addendum has been prepared to clarify, modify, delete, or add to the drawings and/or specifications for the above referenced project, and revisions to items listed here shall supersede description thereof prior to the above stated date. All conditions not specifically referenced here shall remain the same. It is the obligation of the Prime Contractor to make subcontractors aware of any items herein that may affect submitted bids.

Acknowledge receipt of this addendum by inserting its number and date in the bidding documents. Failure to do so may subject bidder to disqualification.

All addenda items refer to the plans and specifications unless specifically noted otherwise.

ADDENDUM #2

WJUSD ADULT ED CTE CLASSROOM RENOVATIONS

The Bid Documents are hereby amended as follows:

PART A – BIDDING AND CONTRACT REQUIREMENTS

AD2A.01 N/A

PART B – TECHNICAL REQUIREMENTS

AD2B.01 Delete Section 064116, Part 2.1.D.1.b. Color core HPL is not required.
AD2B.02 Section 064116, Part 2.2.E.2. shall be revised to read: “Drawer Sides and Backs:
Thermoset decorative panels with PVD or polyester edge banding.”

PART C – DRAWINGS

AD2C.01 Added structural drawings (S0.1, S2.1, S2.2) for clarification of HVAC support framing.
AD2C.02 Revised Mechanical drawings to address DSA comments (M0.2, M0.5, M2.1, M5.1,
M5.2). Revisions are clouded.
AD2C.03 Revised Plumbing drawing (P0.1) for corrected water heater model.
AD2C.04 Revised Electrical drawing (E1.1) to provide a scalable site plan.

PART D – RFI RESPONSES

AD2D.01 There is new HVAC & Structural roof framing as part of this project. However, there is no
Architectural Roof Plan or Division 07 Thermal & Moisture Protection Roofing
Specification sections. Please provide Roofing Specifications and Architectural Roofing
plan showing new roofing or new roofing Patch areas with details for unit curbs. If this is
a patch job only, please also provide the existing roofing specifications and warranty
information.
a. Existing roofing is TPO and is expected to be patched in-kind as required.
AD2D.02 There is no Architectural Reflected Ceiling Plan or Division 09 Ceiling Specification
indicating any ceiling work. Please provide an Architectural Reflected Ceilings plan if
there is any work to the ceilings, except for the A1 finish schedule for new Paint finishes.
Please confirm all new conduit for FA / Power & Lighting, is to be run exposed and
painted on the existing ceilings?
a. Unless otherwise shown on the drawings, new conduit may be run exposed and painted to
match the wall/ceiling surface.
AD2D.03 Sheet A2.1 N13 calls for New Lockers. Note N13 refers you to detail 10/A9.1. There are
currently no Specifications for Locker Type etc. Please provide Specifications for Metal
Lockers.
a. Please refer to Addendum 1.
AD2D.04 Section 064116, Part 1.1.B.2 refers to Section 123623.13 for the plastic laminate clad
countertops, but there is no such section provided.
a. Section 123623.13 does not apply. Information on Plastic-Laminate Countertops may be
found in Section 064116, Part 2.3.

ADDENDUM #2

WJUSD ADULT ED CTE CLASSROOM RENOVATIONS

- AD2D.05 Section 064116, Part 2.3.F.1 refers to high-pressure laminate on a wood product core, but the color is shown as Formica Trespa Black craquele, CO_09 color rather than laminate. Formica does not manufacture Trespa. The color does not show up as a Formica color. Trespa is available in 13 mm or 20 mm panels rather than normal plastic laminate thicknesses, but countertops are sometimes (but not commonly) fabricated from Trespa Request: Please clarify if a HPL is desired for the countertops or if Trespa is desired.
- a. Provide Trespa in 20mm panels wherever HPL countertops are referenced.
- AD2D.06 Roughly, when would the casework install?
- a. Coordinate with the General Contractor for a specific schedule. Refer to project documents for preliminary construction schedule.
- AD2D.07 Please verify that this project does not have Skilled and Trained Workforce requirements.
- a. STW requirements depend on many factors. It is not a direct requirement of the District or the project documents. Please verify this with your General Contractor.
- AD2D.08 Please verify that this is not a union job.
- a. This is a Public project and therefore Prevailing Wage and other requirements do apply to this project. These requirements depend on many factors. It is not a direct requirement of the District or the project documents that this be a "Union job". Please verify this with your General Contractor.
- AD2D.09 Please verify that there is no 12623.13 Plastic Laminate Clad Countertops spec.
- a. Section 123623.13 does not apply.
- AD2D.10 Please verify that plastic laminate material will not be color core.
- a. Delete Section 064116, Part 2.1.D.1.b. Core color does not have to match the top finish.
- AD2D.11 Premium and metallic plastic laminate colors and finishes can vary dramatically in price and availability. Please verify I can price this using standard colors and finishes.
- a. Section 064116, Part 2.1.D.1. lists "solid colors", "wood grains", and "patterns". Owner will select a solid gray color cabinet body color from the laminate manufacturer's standard color selections. No metallic or premium finishes will be required.
- AD2D.12 Please verify that T-mold is not required for the edge banding.
- a. If plastic-laminate shelves are required, PVC T-mold is required for edges of plastic-laminate shelves. All shelving inside cabinets may be thermoset decorative panels.
- AD2D.13 Please verify that drawer bottoms can be MDF (not hardboard). MDF can receive melamine and therefore match the rest of the drawer box.
- a. This is acceptable.
- AD2D.14 Please verify that our drawer boxes can be built using dowelled construction (not rabbeted).
- a. This is acceptable.
- AD2D.15 The specs call out for flush overlay and for 5-knuckle hinges (which give a reveal overlay). Please clarify if the design intent is 5-knuckle/reveal overlay or concealed hinges/flush overlay.
- a. Intent is for a narrow reveal overlay, approximately 1/2-inch. Hinges will be visible.
- AD2D.16 Please verify we are approved to use the standard hole system for the adjustable cabinet shelves (not metal standards). This is WI compliant for all grades.
- a. This is acceptable.

ADDENDUM #2

WJUSD ADULT ED CTE CLASSROOM RENOVATIONS

- AD2D.17 Please verify we are approved to use Pro Series 2.0 100# drawer guides (see attached). They meet the specs requirements.
- a. No attachment was forwarded or received. Drawer guides that fully meet the requirements of the specifications will be accepted as equal.
- AD2D.18 Please provide a scalable Electrical Site Plan. Currently provide on E1.1 appears to be a picture and is NTS.
- a. See revised E1.1 in this addendum for scaled site plan.
- AD2D.19 Sheet A2.3 has the Culinary Equipment schedule / Dental Equipment schedule / Manufacturing Equipment schedule. Please indicate on these schedules the OFCI items and if any equipment is to be CFCI equipment on these schedules? Please supply Installation Specifications for all OFCI equipment.
- a. All equipment listed in the Manufacturing classroom will be installed by the Owner's third-party vendor.
- b. All equipment listed in the Dental classroom will be installed by the Owner's third-party vendor except for the following: XRAY Pass Through Cabinet.
- c. All equipment listed in the Culinary classroom will be installed by the Owner's third-party vendor except for the following: Condensate Hood, Exhaust Hood, Sinks, S/S Liner Panels.

List of Attachments

- Structural drawings (S0.1, S2.1, S2.2)
- Mechanical drawings (M0.2, M0.5, M2.1, M5.1, M5.2)
- Plumbing drawing (P0.1)
- Electrical drawing (E1.1)

A R C H I T E C T

Synthesis Partners, LLC
PO Box 1900
Yuba City, CA 95992



Gary M. Underhill, AIA

March 30, 2023
DATE

GENERAL NOTES

DESIGN CRITERIA

1. CODE: 2022 CALIFORNIA BUILDING CODE (CBC)

2. DESIGN LIVE LOADS:

AREA	LIVE LOAD	REMARKS
ROOF		
A) FLAT TO < 4:12	Lr = 20 PSF	REDUCIBLE PER CODE
B) 4:12 TO < 12:12	Lr = 12-20 PSF	REDUCIBLE PER CODE
FLOOR	L = 0 PSF	REDUCIBLE PER CODE

3. SNOW DESIGN PARAMETERS:

N/A

4. WIND DESIGN PARAMETERS:

ULTIMATE DESIGN WIND SPEED (3-SEC GUST)	Vult = 100 MPH
NOMINAL DESIGN WIND SPEED (3-SEC GUST)	Vasd = 77 MPH
RISK CATEGORY	III
EXPOSURE CATEGORY	C
INTERNAL PRESSURE COEFFICIENT	±0.18
ANALYSIS METHOD	DIRECTIONAL PROCEDURE

ROOF PRESSURE FOR COMPONENTS & CLADDING:

N/A

5. EARTHQUAKE DESIGN PARAMETERS:

4.1. SEISMIC IMPORTANCE FACTOR	Ie = 1.25
4.2. RISK CATEGORY	III
4.3. SOIL SITE CLASSIFICATION	'D'
4.4. SEISMIC DESIGN CATEGORY	'D'
4.5. MAPPED SPECTRAL RESPONSE ACCEL	
A) SHORT PERIOD	Se = 1.011g
B) 1-SEC PERIOD	Si = 0.354g
5.6 DESIGN SPECTRAL RESPONSE ACCEL	
A) SHORT PERIOD	Sds = 0.209g
B) 1-SEC PERIOD	Sdi = 0.401g
5.7 SEISMIC FORCE RESISTING SYSTEM	WOOD SHEARWALLS
5.8 SEISMIC BASE SHEAR	V = N/A
5.9 SEISMIC RESPONSE COEFFICIENT	Cs = N/A
5.10 RESPONSE MODIFICATION FACTOR	R = 6.5
5.11 COMPONENT AMPLIFICATION FACTOR	
A) CONDENSER & HVAC	Ap = 2.5
5.12 COMPONENT RESPONSE MODIFICATION FACTOR	
A) CONDENSER & HVAC	Rp = 6.0
5.13 ANALYSIS PROCEDURE	EQUIVALENT LATERAL FORCE

DEMOLITION

- SHORE OR BRACE TRUSSES, BEAMS, COLUMNS, AND WALLS AS REQUIRED TO MAINTAIN THE STABLE INTEGRITY OF THE EXISTING STRUCTURE PRIOR TO DEMOLITION. IT IS THE CONTRACTOR'S SOLE RESPONSIBILITY TO DESIGN AND PROVIDE COMPETENT SHORING AND BRACING FOR ALL LOADS IMPOSED DURING AND AFTER DEMOLITION THROUGH COMPLETION OF NEW CONSTRUCTION.
- ALL DIMENSIONS GIVEN TO AND OF THE EXISTING STRUCTURE ARE APPROXIMATE. VERIFY BY FIELD MEASUREMENTS THE DIMENSIONS OF THE EXISTING STRUCTURE. WHERE ACTUAL CONDITIONS DEVIATE FROM THE DETAILS SHOWN ON THE DRAWINGS, NOTIFY THE STRUCTURAL ENGINEER FOR INSTRUCTIONS PRIOR TO PROCEEDING WITH WORK.
- DEMOLITION AND REMOVAL OF EXISTING CONSTRUCTION SHALL BE MADE IN SUCH A MANNER AS TO AVOID OR MINIMIZE DAMAGE TO ADJACENT CONSTRUCTION.
- EXTENT OF DEMOLITION IS TO BE AS INDICATED ON PLANS, SECTIONS AND DETAILS. DEMOLITION IS TO INCLUDE REMOVAL AND DISPOSAL CONSTRUCTION.

STRUCTURAL STEEL

- FABRICATION, ERECTION AND MATERIALS SHALL CONFORM TO THE SPECIFICATIONS AND STANDARDS OF THE AISC, AS CONTAINED IN THE "AISC 360-10 SPECIFICATIONS OF STRUCTURAL STEEL BUILDING" & THE "AISC MANUAL OF STEEL CONSTRUCTION", 14TH EDITION AND CALIFORNIA BUILDING CODE LATEST EDITION.
- STRUCTURAL STEEL SHALL CONFORM TO THE FOLLOWING SPECIFICATIONS, U.O.N.

SHAPES	
WIDE FLANGES (W, WT, S, M)	ASTM A992
CHANNEL (C), MISC CHANNEL (MC), ANGLES (L)	ASTM A36
HOLLOW STRUCTURAL STEEL (HSS)	ASTM A500, Gr. B
STEEL CIRCULAR PIPES (P)	ASTM A53, TYPE E OR S, GR. B
PLATES & BARS	
COLUMN BASE PLATES	ASTM A36
BRACE GUSSET PLATES	ASTM A36
BEAM SHEAR CONNECTION PLATES	ASTM A36
COLUMN CONTINUITY PLATES	ASTM A572, Gr. 50
BEAM STIFFENER PLATES	ASTM A36
DECK CLOSURE PLATES	ASTM A36
STAINLESS STEEL PLATES & BARS	ASTM A276
OTHER	ASTM A36
NUTS, BOLTS, RODS & WASHERS	
GENERAL BOLTS	ASTM A325-N
SLIP CRITICAL BOLTS (SEE NOTE #4 BELOW)	ASTM A325-SC
HIGH STRENGTH BOLTS	ASTM A325-N OR A490
MACHINE BOLTS (GENERAL USE)	ASTM A307
BENT & HEADED ANCHOR BOLTS	ASTM F1554, Gr. 36, 55, OR 105
PARTIAL & FULLY THREADED ANCHOR RODS	ASTM F1554, Gr. 36, 55, OR 105
FULLY THREADED RODS (GENERAL USE)	ASTM A36 (A307 Gr. A for 3/8" Φ)
WELDED SHEAR CONNECTORS	ASTM A108, Gr. 1015 thru 1020
WELDED TREADED STUDS	ASTM A108, Gr. 1015 thru 1020
NUTS FOR BOLTS & MACHINE BOLTS	ASTM A563
HARDENED WASHERS	ASTM F436
UNHARDENED WASHERS	ASTM F844
PLAIN WASHERS	ASTM B18.22.1
BEVELED WASHERS	ASTM B18.23.1

- BOLTED CONNECTIONS SHALL CONSIST OF UNFINISHED BOLTS PER THE TABLE ABOVE UNLESS NOTED OTHERWISE. ANCHOR BOLTS CAST IN CONCRETE OR MASONRY SHALL BE HEADED BOLTS w/ CUT THREAD, FULL DIAMETER BODY STYLE CONFORMING TO ASTM F1554 U.O.N. UNLESS NOTED OTHERWISE. ANCHOR BOLTS SHALL BE GRADE 55 PER SI SUPPLEMENTARY REQUIREMENTS. ALL BOLTED CONNECTIONS AND BASE PLATES SHALL HAVE STANDARD CUT WASHERS UNLESS NOTED OTHERWISE. WASHERS AT BASE SHALL BE PLACED AT TOP AND BOTTOM OF PLATE.
- "SLIP"-CRITICAL BOLTED CONNECTIONS:
 - "SLIP"-CRITICAL CONNECTIONS (A325-SC DESIGN VALUES w/ SPECIAL INSPECTION) ARE REQUIRED AT ALL BRACED FRAME CONNECTIONS, AT ALL CONNECTIONS ALONG CHORD LINES AND DRAG LINES (AS NOTED ON PLANS) AND U.O.N. AT ALL BOLTS IN OVERSIZED OR SLOTTED HOLES.
 - THE SPECIAL INSPECTOR MUST BE PRESENT DURING INSTALLATION AND TIGHTENING OPERATION OF "SLIP"-CRITICAL CONNECTIONS.
- ALL STRUCTURAL STEEL SHALL RECEIVE MINIMUM OF ONE SHOP COAT OF RED PRIMER w/ A MINIMUM DRY FILM THICKNESS OF 2.0 MILS. DO NOT SHOP PRIME OR PAINT AREAS TO BE FIELD WELDED, FIREPROOFED, GALVANIZED, TO RECEIVE SLIP-CRITICAL HIGH STRENGTH BOLTS, OR TO BE EMBEDDED IN CONCRETE. PRIOR TO PRIMING OR PAINTING, CLEAN STRUCTURAL STEEL & AS REQUIRED BY THE PRIMER & PAINT MANUFACTURER, PROVIDE ADDITIONAL PAINTING AS NOTED IN THE SPECIFICATIONS.
- ALL STRUCTURAL STEEL SHALL BE ERECTED PLUMB AND TRUE TO LINE. TEMPORARY BRACING SHALL BE INSTALLED AND SHALL BE LEFT IN PLACE UNTIL OTHER MEANS ARE PROVIDED TO ADEQUATELY BRACE THE STRUCTURE. CONTRACTOR RESPONSIBLE FOR REVIEWING ALL BASE PLATE AND SUPPORT CONDITIONS DURING ERECTION AND BRACING AS REQUIRED. SEE AISC AND OSHA REQUIREMENTS.
- PLACE NON-SHRINK GROUT UNDER ALL BASE PLATES BEFORE ADDING VERTICAL LOAD. SEE CONCRETE NOTES FOR NON-SHRINK GROUT REQUIREMENTS.
- STRUCTURAL STEEL BELOW GRADE SHALL HAVE 3" MINIMUM OF CONCRETE COVER.
- PROVIDE 1/2" Φ STITCH BOLTS AND RING FILLS, SPACE AT NOT MORE THAN 24" CG FOR ALL DOUBLE ANGLE MEMBERS.
- AT WOOD TO STEEL PARALLEL CONTACT, ATTACH w/ 1/2" Φ WELDED THREADED STUDS AT MAXIMUM 3'2" CG, & 6" FROM ENDS OF WOOD MEMBER, TYPICAL UNLESS NOTED OTHERWISE.
- HOLES FOR UNFINISHED BOLTS SHALL BE OF THE SAME NOMINAL DIAMETER OF THE BOLTS PLUS 1/16". USE STANDARD AISC GAGE AND PITCH FOR BOLTS EXCEPT AS NOTED OTHERWISE. HOLES FOR ANCHOR BOLTS EMBEDDED IN CONCRETE SHALL BE OF THE SAME NOMINAL BOLT DIAMETER PLUS 3/16" UNLESS NOTED OTHERWISE.
- WELDING SHALL BE DONE BY THE ELECTRIC ARC PROCESS IN ACCORDANCE w/ AMERICAN WELDING SOCIETY STANDARDS, USING ONLY CERTIFIED WELDERS. ALL GROOVE WELDS SHALL HAVE COMPLETE PENETRATION UNLESS NOTED OTHERWISE. ALL EXPOSED WELDS SHALL BE GRIND SMOOTH. ALL WELDING TO BE DONE USING E70XX ELECTRODES. IN ADDITION, WELDING OF ASTM A572 GRADE 50 STEEL AND ASTM A992 STEEL SHALL BE DONE w/ ELECTRODES CAPABLE OF DEPOSITING WELD METAL w/ A MAXIMUM DIFFUSIBLE HYDROGEN CONTENT OF 10ml/100g (HI6). WELD LENGTHS CALLED FOR ON PLANS ARE THE NET EFFECTIVE LENGTHS REQUIRED.
- MINIMUM FILLET WELDS:
 - 3/16" @ t < 1/2"
 - 1/4" @ t < 3/4"
 - 3/8" @ t > 3/4"
- WELDING PROCEDURES SPECIFICATIONS (WPS) FOR SHOP AND FIELD PRE-QUALIFIED WELD JOINTS AND WELD JOINTS QUALIFIED BY TEST SHALL BE PREPARED FOR REVIEW PRIOR TO FABRICATION. ALL WELDING PROCEDURES THAT MEET THESE REQUIREMENTS OF AWS D1.1 SEC. 5.1 SHALL BE CONSIDERED AS PRE-QUALIFIED. QUALIFICATION TESTING IS REQUIRED WHEN THE DEPTH OF A PARTIAL PENETRATION OR COMPLETE PENETRATION WELD IS 2" OR GREATER.
- STRUCTURAL STEEL & FASTENERS THAT ARE PERMANENTLY EXPOSED TO WEATHER SHALL BE EITHER PRIMED AND PAINTED OR HOT DIPPED GALVANIZED IN ACCORDANCE w/ ASTM A780.
- WHEN STRUCTURAL STEEL & CONNECTIONS WILL BE EXPOSED TO VIEW IN THE COMPLETED BUILDING, THEY SHALL BE FABRICATED, ERECTED & FINISHED IN COMPLIANCE w/ ARCHITECTURALLY EXPOSED STRUCTURAL STEEL (AESS) GUIDELINES & SECTION 10 OF THE AISC 303-05 "CODE OF STANDARD PRACTICE FOR STEEL BUILDINGS AND BRIDGES".

WOOD

- ALL SAWN LUMBER SHALL BE DOUGLAS FIR-LARCH AS GRADED BY THE WEST COAST LUMBER INSPECTION BUREAU (NCLIB) IN ACCORDANCE w/ STANDARD GRADING RULES NO. 17 TYPICAL UNLESS NOTED OTHERWISE. ALL MEMBERS SHALL HAVE A MINIMUM GRADE OF NO. 1 EXCEPT 2x4 AND 2x6 WALL STUDS, PLATES, AND BLOCKING MAY BE NO. 2.
- ALL STRUCTURAL SHEATHING USED FOR SHEARWALLS AND ROOF SHEATHING SHALL CONFORM TO THE REQUIREMENTS FOR THEIR TYPE IN DOC P5.1, DOC P5.2 OR ANSI/APA PRF 210. EACH PANEL OR MEMBER SHALL BE IDENTIFIED FOR GRADE, BOND CLASSIFICATION, AND PERFORMANCE CATEGORY BY THE TRADEMARKS OF AN APPROVED TESTING AND GRADING AGENCY.
- ALL FOUNDATION PLATES OR SILLS ON CONCRETE SLABS WHICH ARE IN DIRECT CONTACT w/ EARTH, AND PLATES OR SILLS ON CONCRETE OR MASONRY FOUNDATIONS, SHALL BE PRESSURE TREATED.
- ALL WOOD SHALL HAVE A MOISTURE CONTENT OF NOT MORE THAN 19% WHEN SHEATHING IS APPLIED.
- 8" MINIMUM CLEARANCE SHALL BE MAINTAINED AT ALL EXTERIOR WALLS BETWEEN FINISH GRADE AND BOTTOM OF WOOD WALLS.
- BEARING AND SHEARWALLS SHALL HAVE DOUBLE TOP PLATES LAPPED AT WALL CORNERS AND INTERSECTIONS AND PLATES SHALL BE INTERNAILED w/ (3) 16d AT SUCH LOCATIONS. FOR PLATE SPLICE DETAILS, SEE DRAWINGS.
- SILL PLATE ANCHOR BOLTS SHALL BE INSTALLED w/ PLATE WASHERS 3x3x0.229 BETWEEN NUT AND PLATE.
- PROVIDE SOLID BLOCKING BETWEEN JOIST AND RAFTERS AT ALL SUPPORTS.
- PROVIDE BLOCKING AT ALL CEILING LEVELS.
- JOIST UNDER AND PARALLEL TO PARTITION SHALL BE DOUBLED AND NAILED TOGETHER.
- HOLES FOR BOLTS IN WOOD SHALL BE BORED w/ A BIT OF THE SAME NOMINAL DIAMETER AS THE BOLT PLUS 1/16".
- HOLES FOR LAG SCREWS SHALL BE BORED AS FOLLOWS:
 - THE CLEARANCE HOLE FOR THE SHANK SHALL HAVE THE SAME DIAMETER AS THE SHANK, AND THE SAME DEPTH OF PENETRATION AS THE LENGTH OF UNTHREADED SHANK.
 - THE LEAD HOLE FOR THE THREADED PORTION SHALL HAVE A DIAMETER EQUAL TO 60% TO 70% OF THE SHANK DIAMETER AND A LENGTH EQUAL TO AT LEAST THE LENGTH OF THE THREADED PORTION.
- LAG SCREWS AND WOOD SCREWS SHALL BE SCREWED AND NOT DRIVEN INTO PLACE. SOAP MAY BE USED TO LUBRICATE THE SCREWS.
- ALL BOLTS AND LAG SCREWS SHALL BE PROVIDED w/ METAL WASHERS UNDER HEADS AND NUTS WHICH BEAR IN WOOD. APPLIES ALSO TO INSERTED EXPANDING FASTENERS, RED HEAD, ETC.

BOLT DIAMETER	M1 WASHERS	STEEL WASHER
3/8" Φ	2 3/4" Φ x 3/16"	3" x 3" x 3/16"
1/2" Φ	3" Φ x 1/8"	3" x 3" x 3/16"
5/8" Φ	3 1/2" Φ x 1/8"	3 1/2" x 3 1/2" x 3/16"
1" Φ	4" Φ x 1/2"	3 3/4" x 3 3/4" x 3/16"

- ALL BOLTS AND LAG SCREWS SHALL BE TIGHTENED AT INSTALLATION AND RETIGHTENED BEFORE CLOSING IN OR AT COMPLETION OF JOB.
- LAY ALL STRUCTURAL SHEATHING ON ROOF AND FLOORS w/ FACE GRAIN PERPENDICULAR TO SUPPORT TYPICAL UNLESS OTHERWISE. USE PLY-CLIPS AT UNSUPPORTED SHEATHING EDGES.
- CONNECTOR HARDWARE MODEL NUMBER ARE THOSE FOR SIMPSON

STRONG-TIE COMPANY. ALL JOIST HANGERS SHALL BE SIMPSON U SERIES UNLESS NOTED OTHERWISE. EQUIVALENT CONNECTORS w/ ICC ACCEPTANCE MAY BE SUBMITTED FOR REVIEW AS AN ALTERNATE.

18. NOTIFY ARCHITECT AFTER WALL, FLOOR, AND ROOF SHEATHING NAILING HAS BEEN COMPLETED AND A MINIMUM OF 48 HOURS PRIOR TO CONCEALING SHEATHING.

19. FASTENERS, NUTS AND WASHERS IN CONTACT w/ SBX/DOT AND ZINC BORATE TREATED WOOD IN INTERIOR DRY CONDITIONS MAY BE CARBON STEEL. FASTENERS IN OTHER PRESERVATIVE-TREATED WOOD (ANCHOR BOLTS, NAILS, SCREWS) SHALL BE APPROVED SILICON BRONZE OR COPPER, STAINLESS STEEL OR HOT-DIPPED ZINC-COATED STEEL PER CBC 2304.9.5. U.O.N.

APPROVALS

PO Box 1900
Yuba City, CA 95992-1900
530.298.7298
www.spinc-arch.com

ARCHITECTURAL • COMMERCIAL • RESIDENTIAL • INTERIOR • CONSTRUCTION MANAGEMENT



SYNTHESIS PARTNERS, LLC
Managers • Architects


OWNER

Woodland Joint Unified School District
435 6th Street
Woodland, CA 95695

PROJECT

ADULT EDUCATION CENTER
CLASSROOM RENOVATIONS
575 Hays Street
Woodland, CA 95695

KEY PLAN

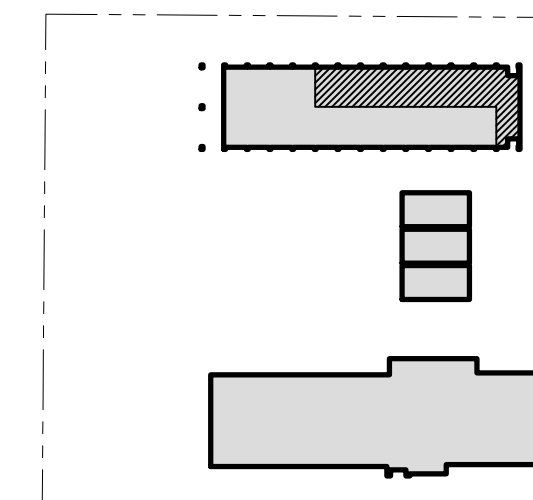


NO.	REVISION DESCRIPTION	DATE


GENERAL NOTES

S0.1

DATE 2023-03-28
PROJECT NO. 21-W04-01

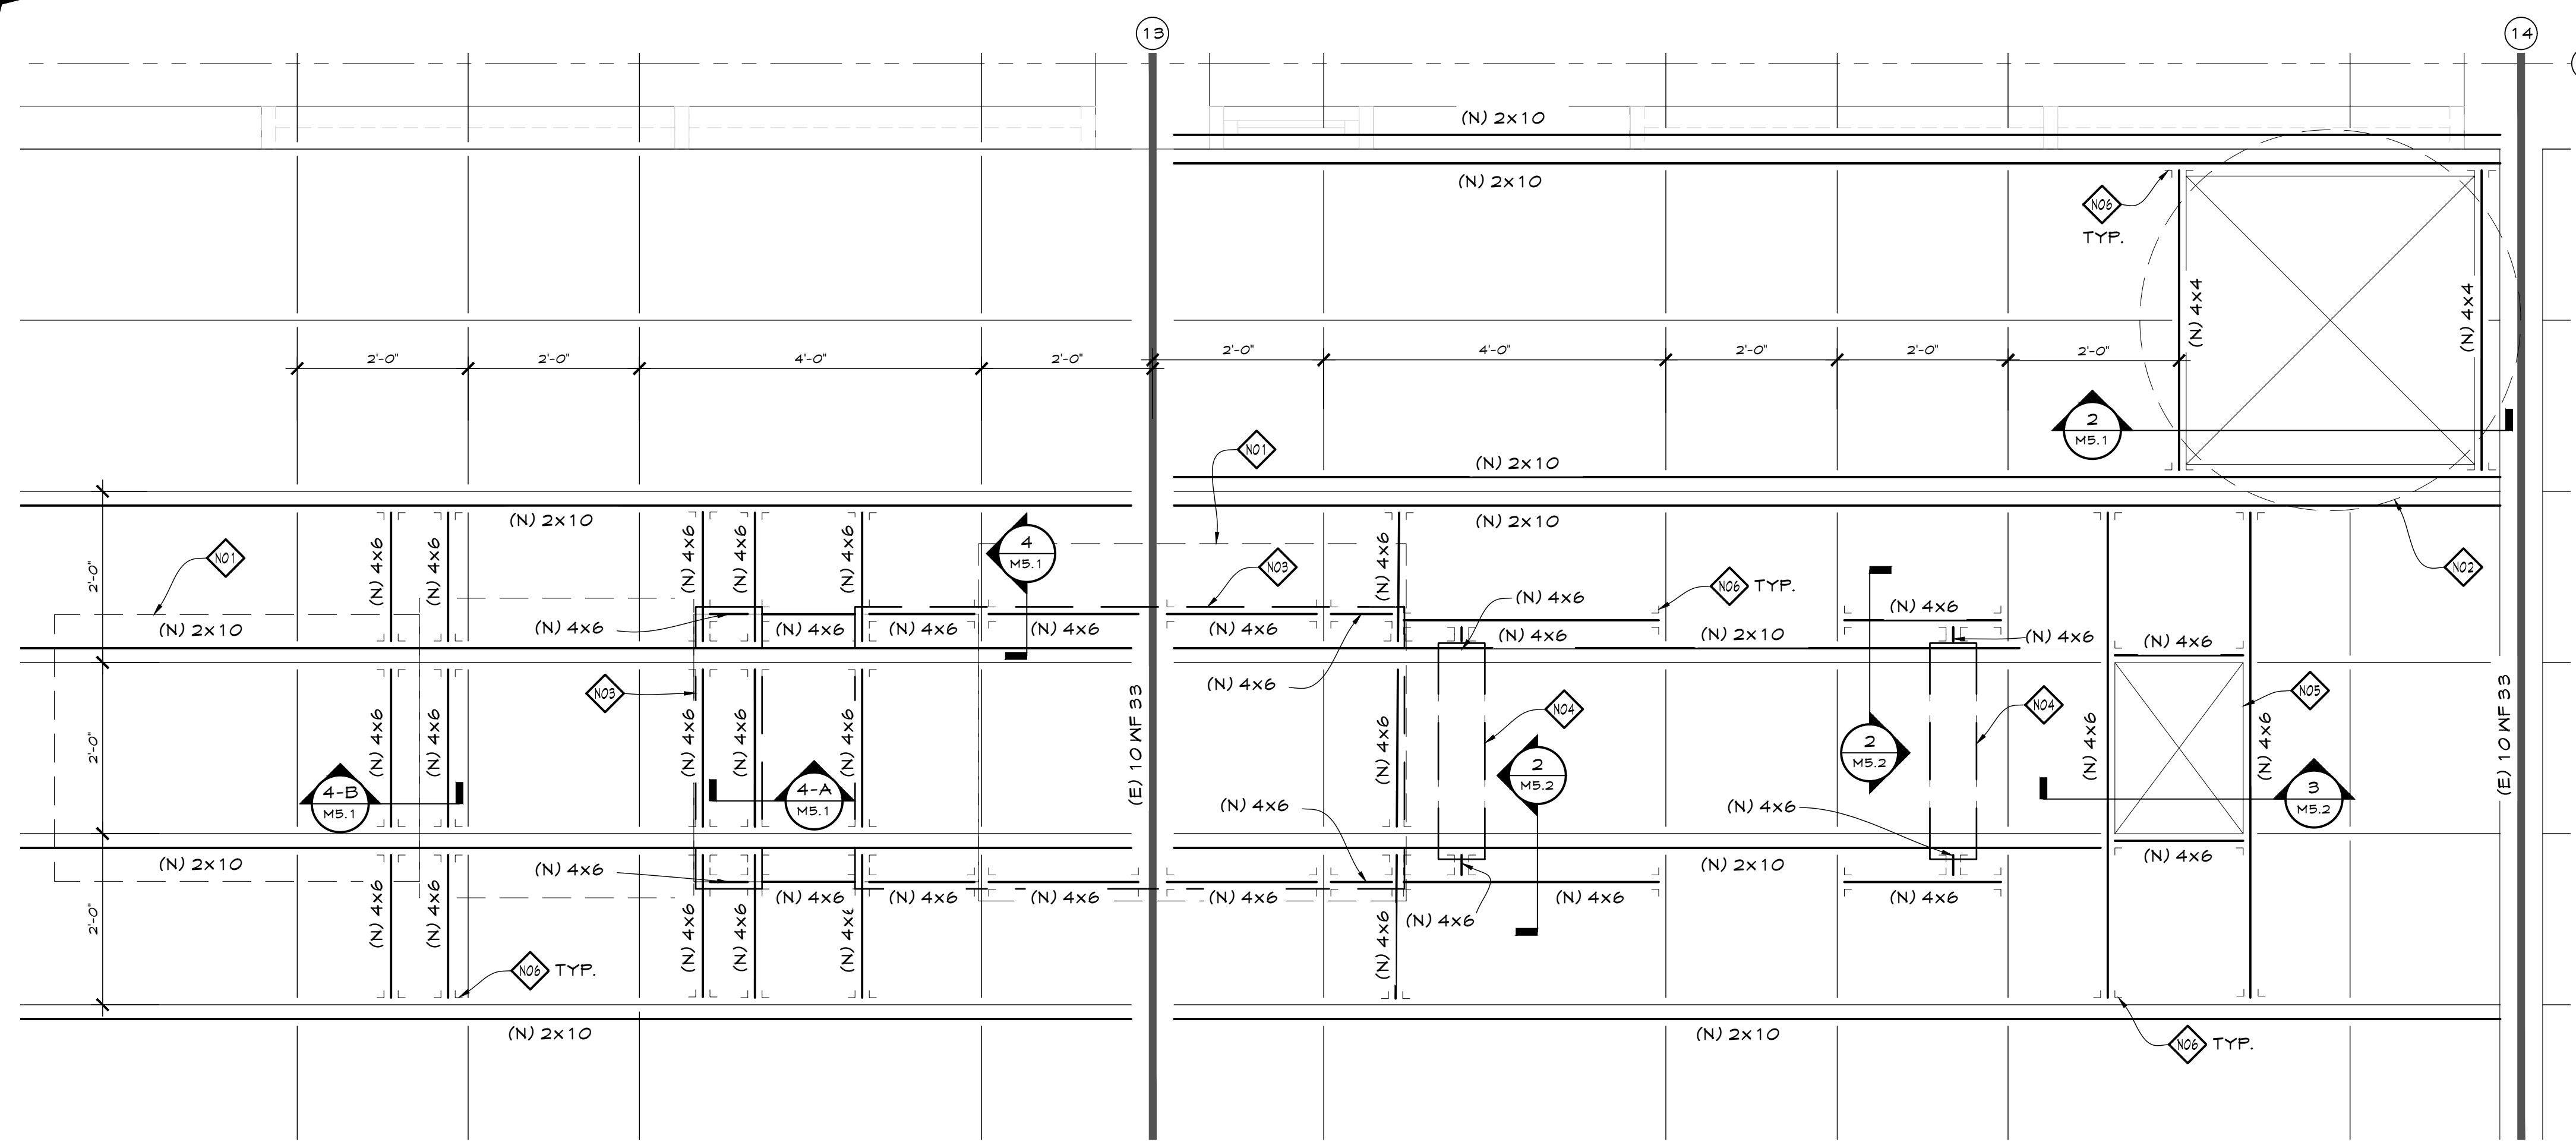

PARTIAL ENLARGED ROOF FRAMNG PLAN SCALE: 3/4" = 1'-0" 2

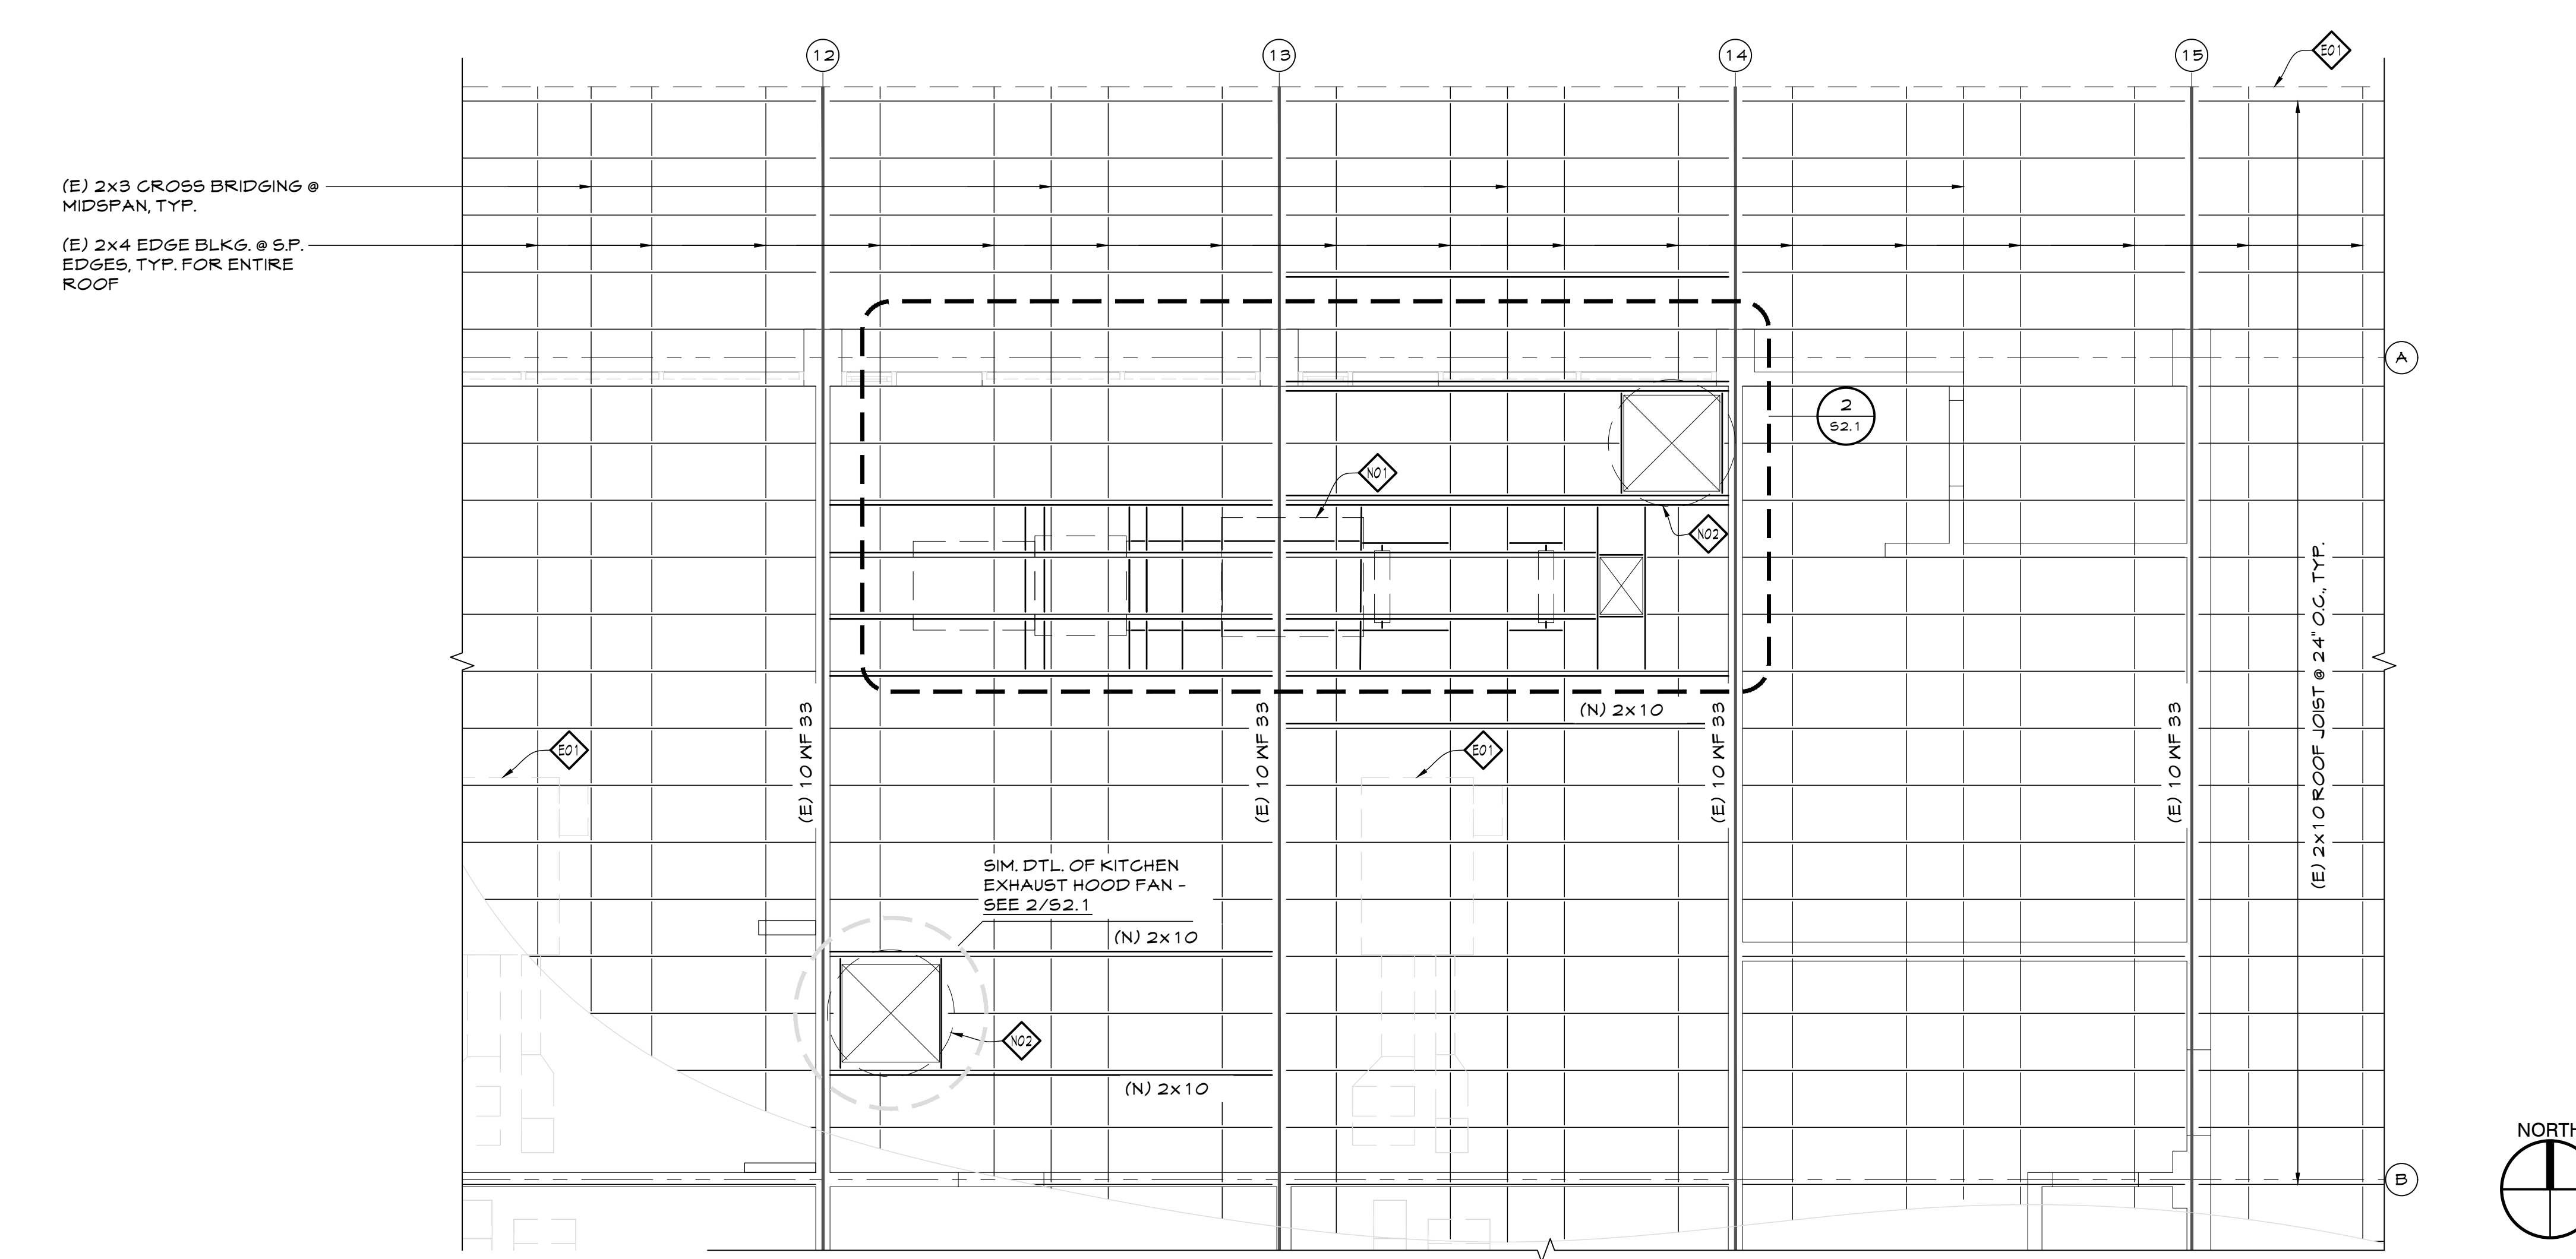

PARTIAL ROOF FRAMNG PLAN SCALE: 1/4" = 1'-0" 1

KEYNOTES

EXISTING

- E01 (2) 2x10 FACIA
- E02 AC EQUIPMENT ON ROOF

NEW / ALTERATION

- N01 MAKE UP AIR UNIT - SEE MECH. DWGS.
- N02 KITCHEN EXHAUST HOOD FAN - SEE MECH. DWGS.
- N03 ROOF CURB - SEE MECH. DWGS.
- N04 DUCT SUPPORT - SEE MECH. DWGS.
- N05 DUCT THRU ROOF - SEE MECH. DWGS.
- N06 A35 EA. SIDE END OF BLKG., TYP.

©2023 Synthesis Partners, LLC. All Rights Reserved.
 These record drawings have been prepared based upon information submitted, in part, by others. While this information is believed to be reliable, the Architect is not responsible for their accuracy, nor for errors or omissions which may have been incorporated into these documents as a result.

APPROVALS

PO Box 1900
 Yuba City, CA 95992-1900
 530.298.7298
 www.spinc-arch.com

ARCHITECTURAL • COMMERCIAL • RESIDENTIAL • INTERIOR • CONSTRUCTION MANAGEMENT





OWNER

Woodland Joint Unified School District
 435 6th Street
 Woodland, CA 95695

PROJECT

ADULT EDUCATION CENTER
 CLASSROOM RENOVATIONS
 575 Hays Street
 Woodland, CA 95695

KEY PLAN

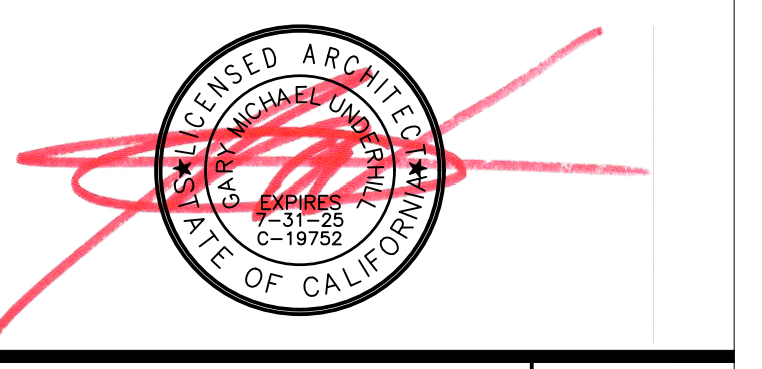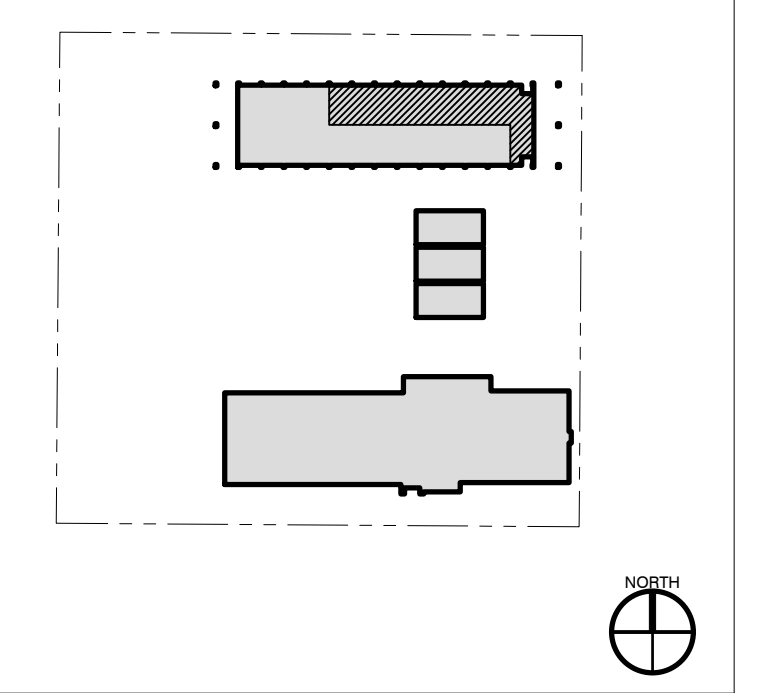


NO.	REVISION DESCRIPTION	DATE


PARTIAL ROOF FRAMNG PLANS

S2.1


DATE	2023-03-28
PROJECT NO.	21-W04-01

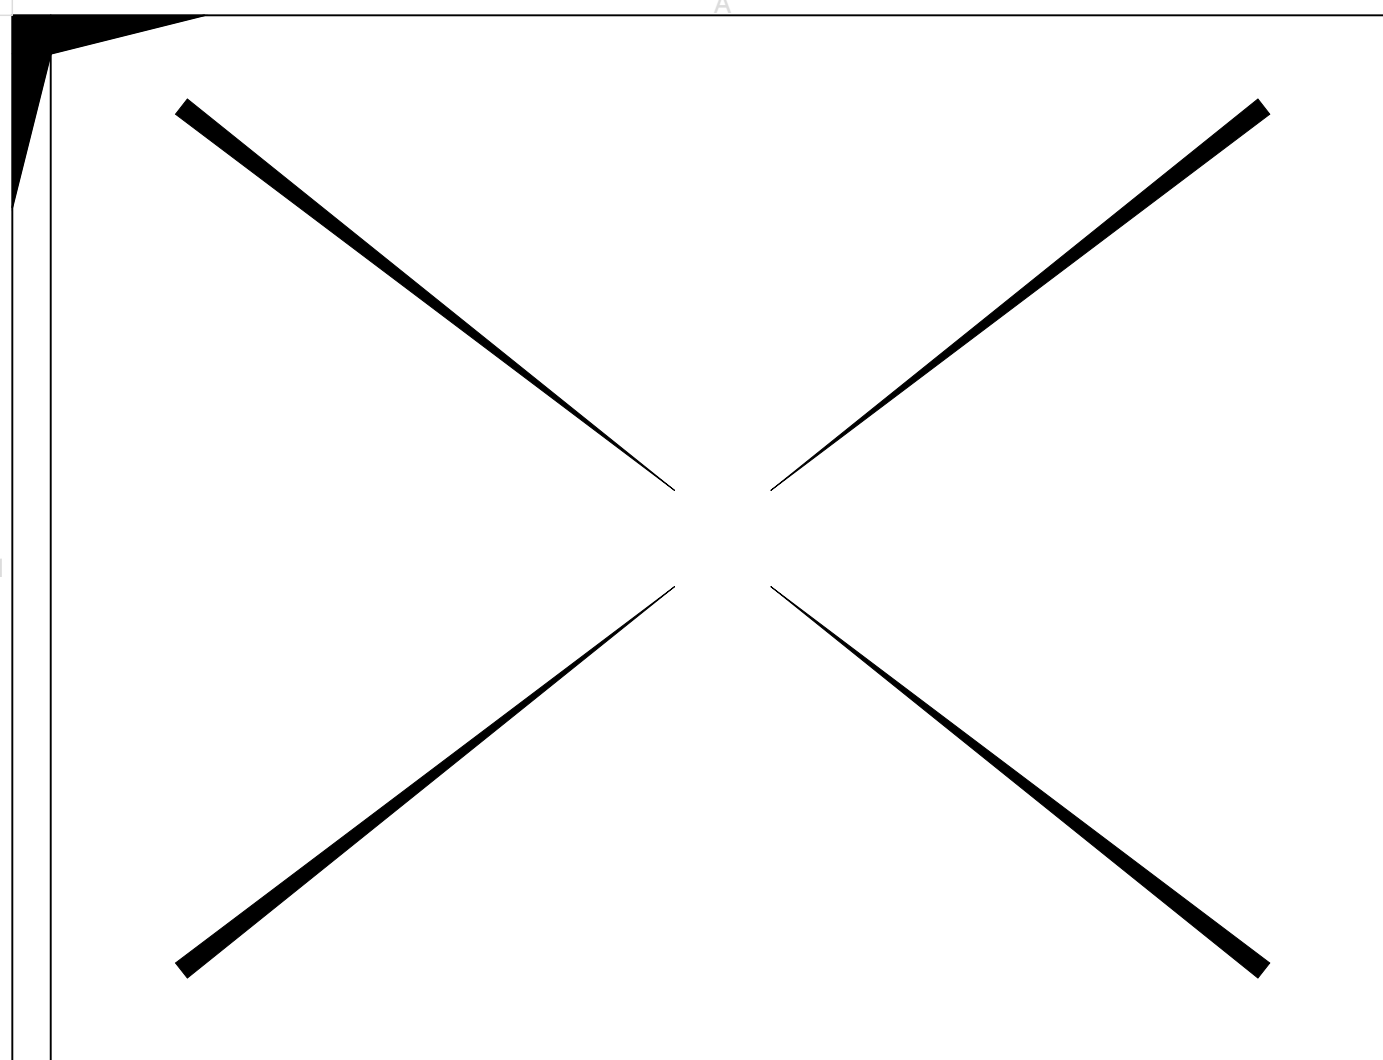


NOT USED SCALE: NONE 16

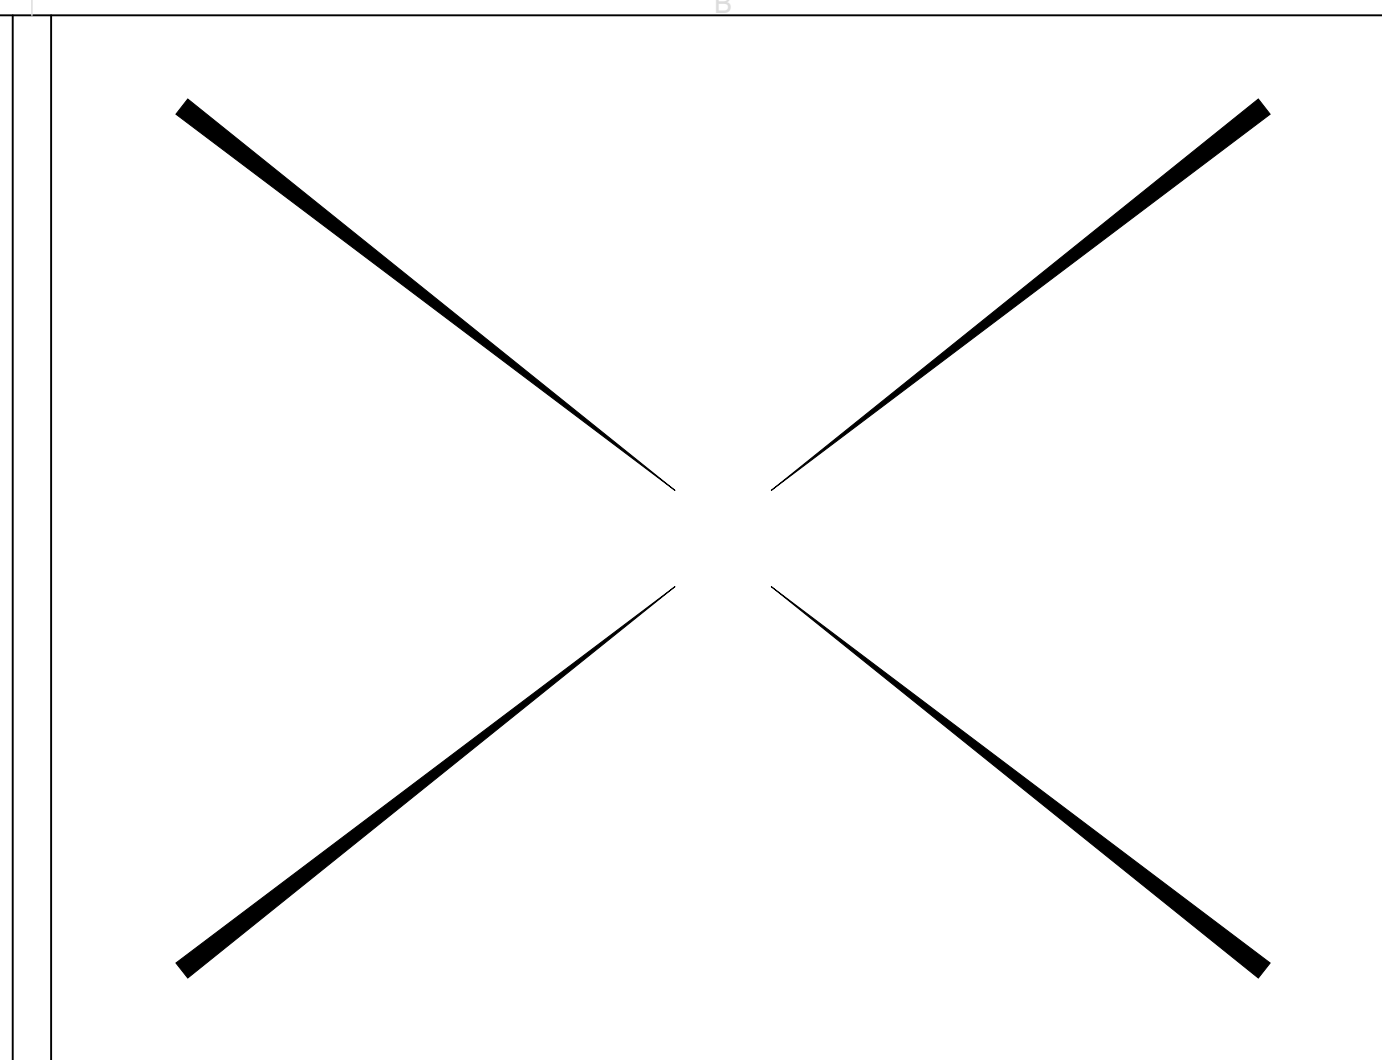


NOT USED SCALE: NONE 12

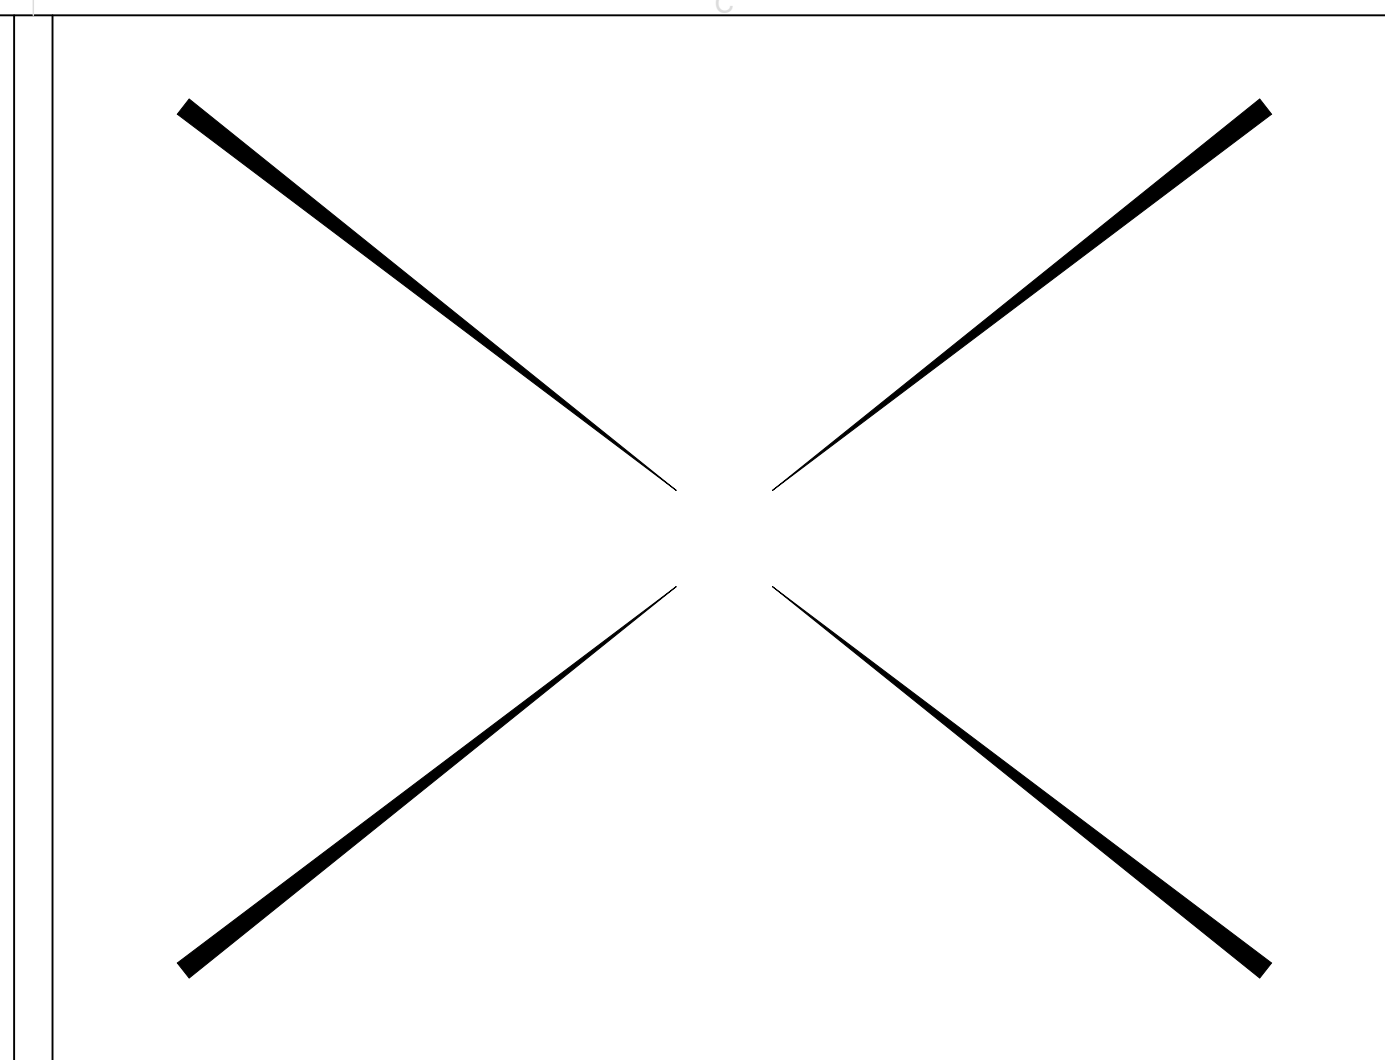


NOT USED SCALE: NONE 8

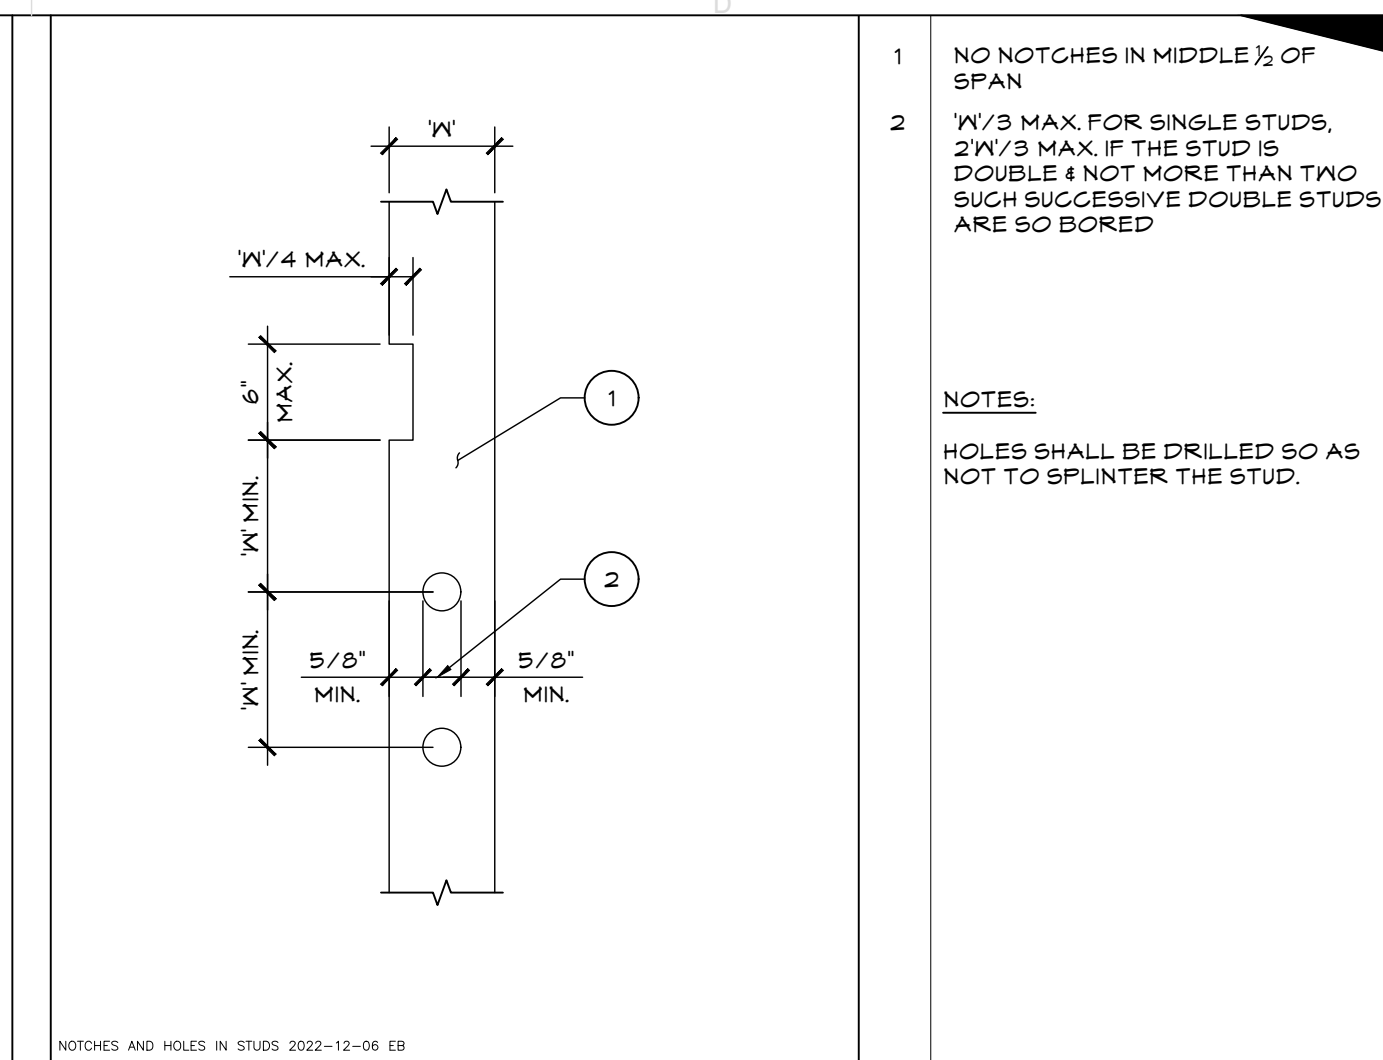


NOTCHES AND HOLES IN STUDS SCALE: 1" = 1'-0" 4

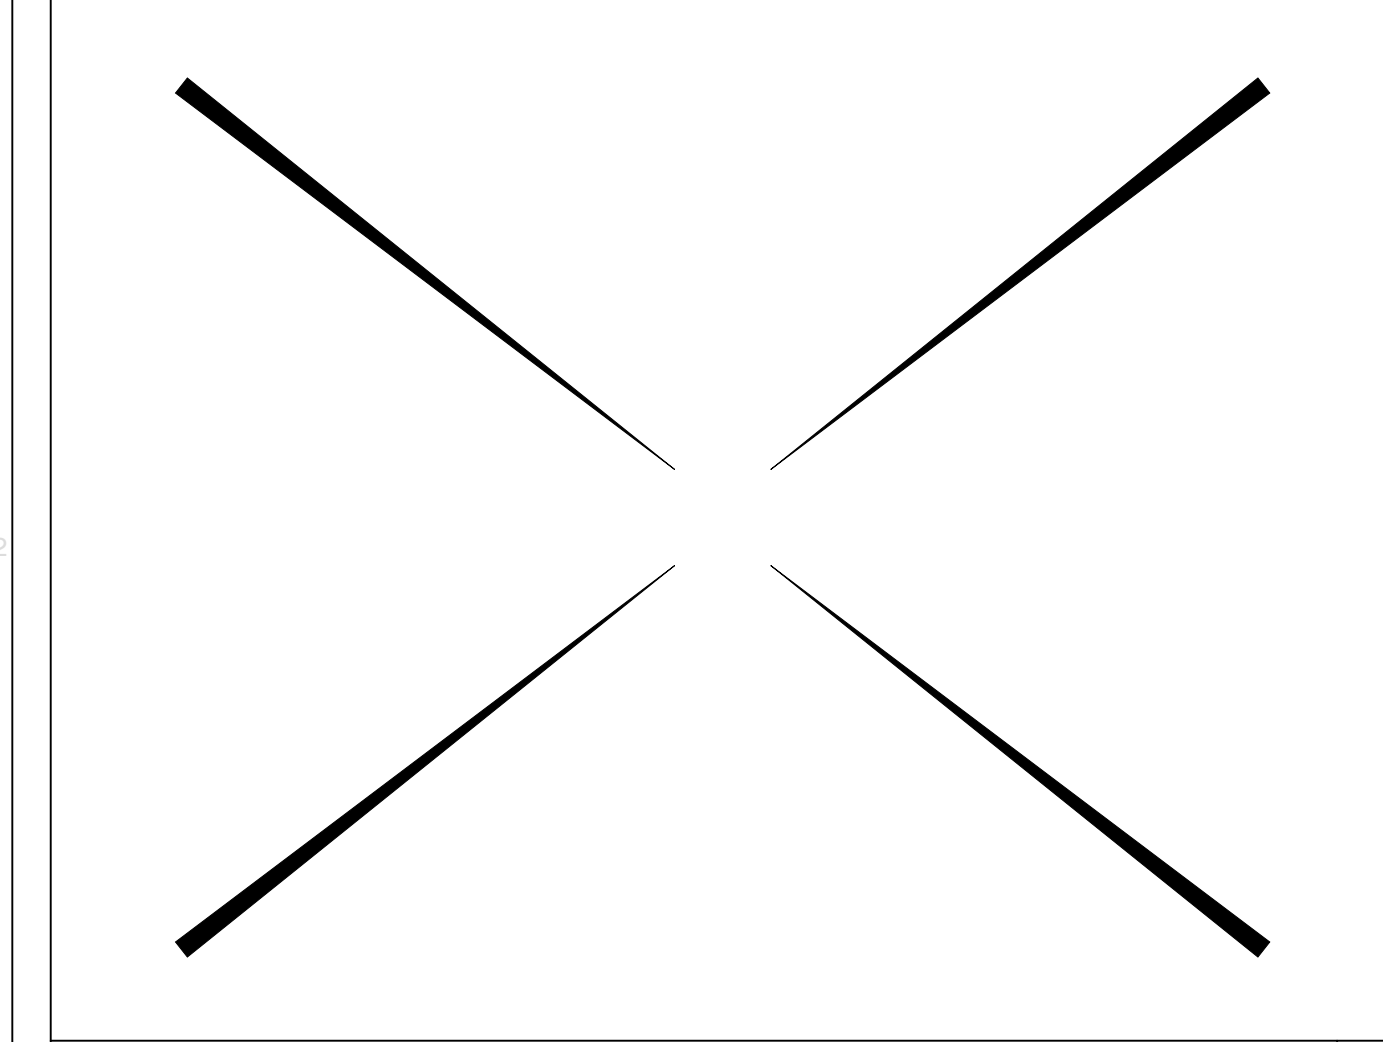


NOT USED SCALE: NONE 15

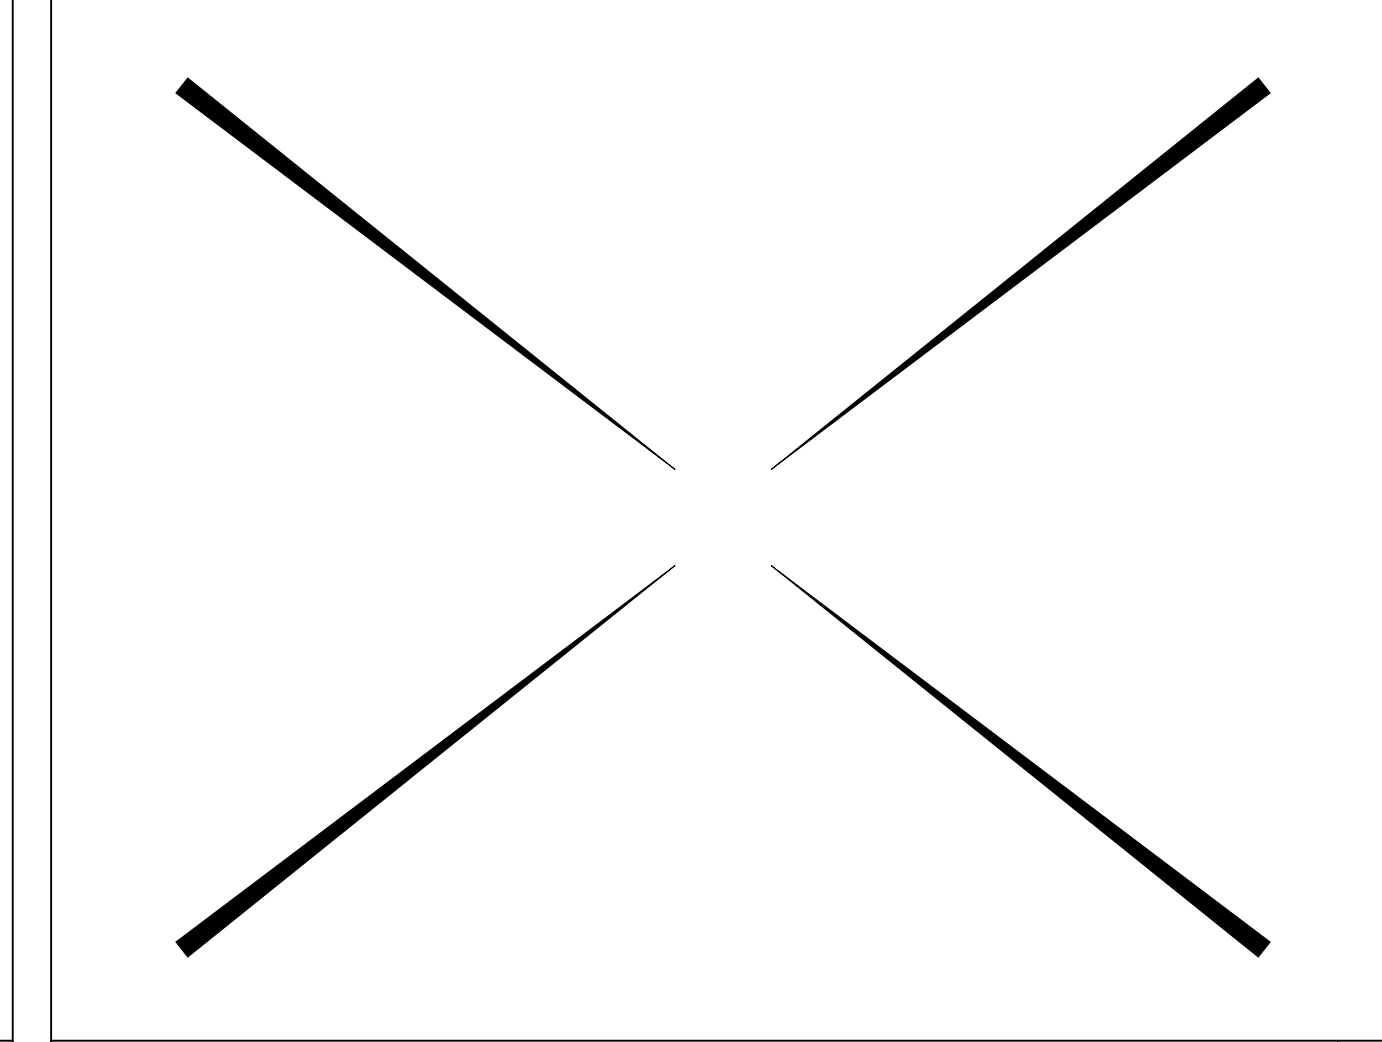


NOT USED SCALE: NONE 11

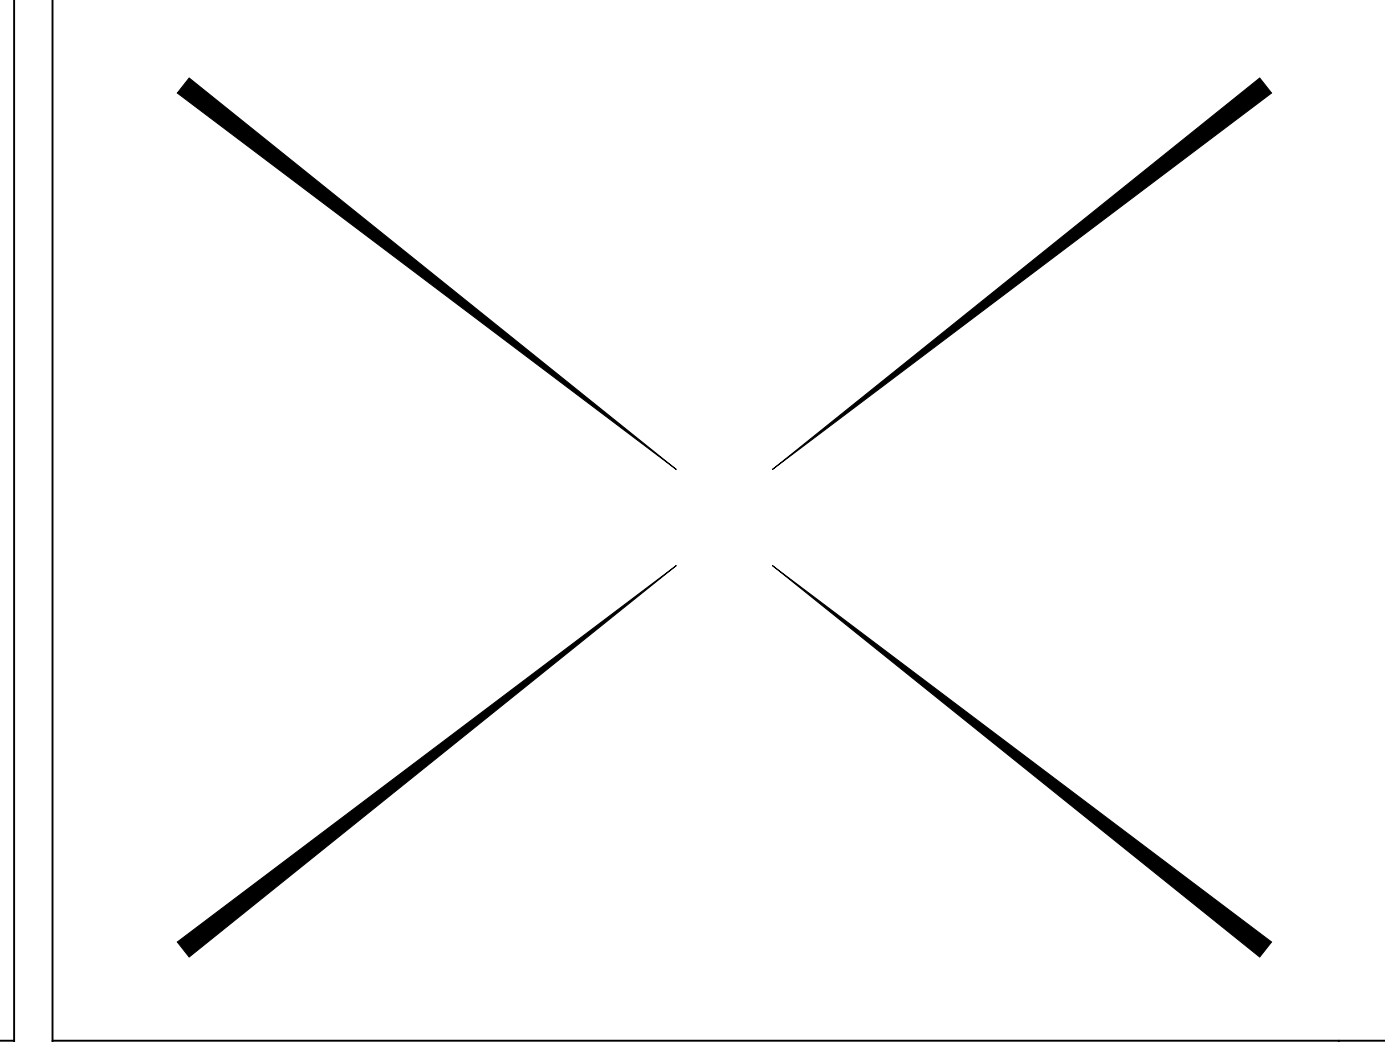


NOT USED SCALE: NONE 7

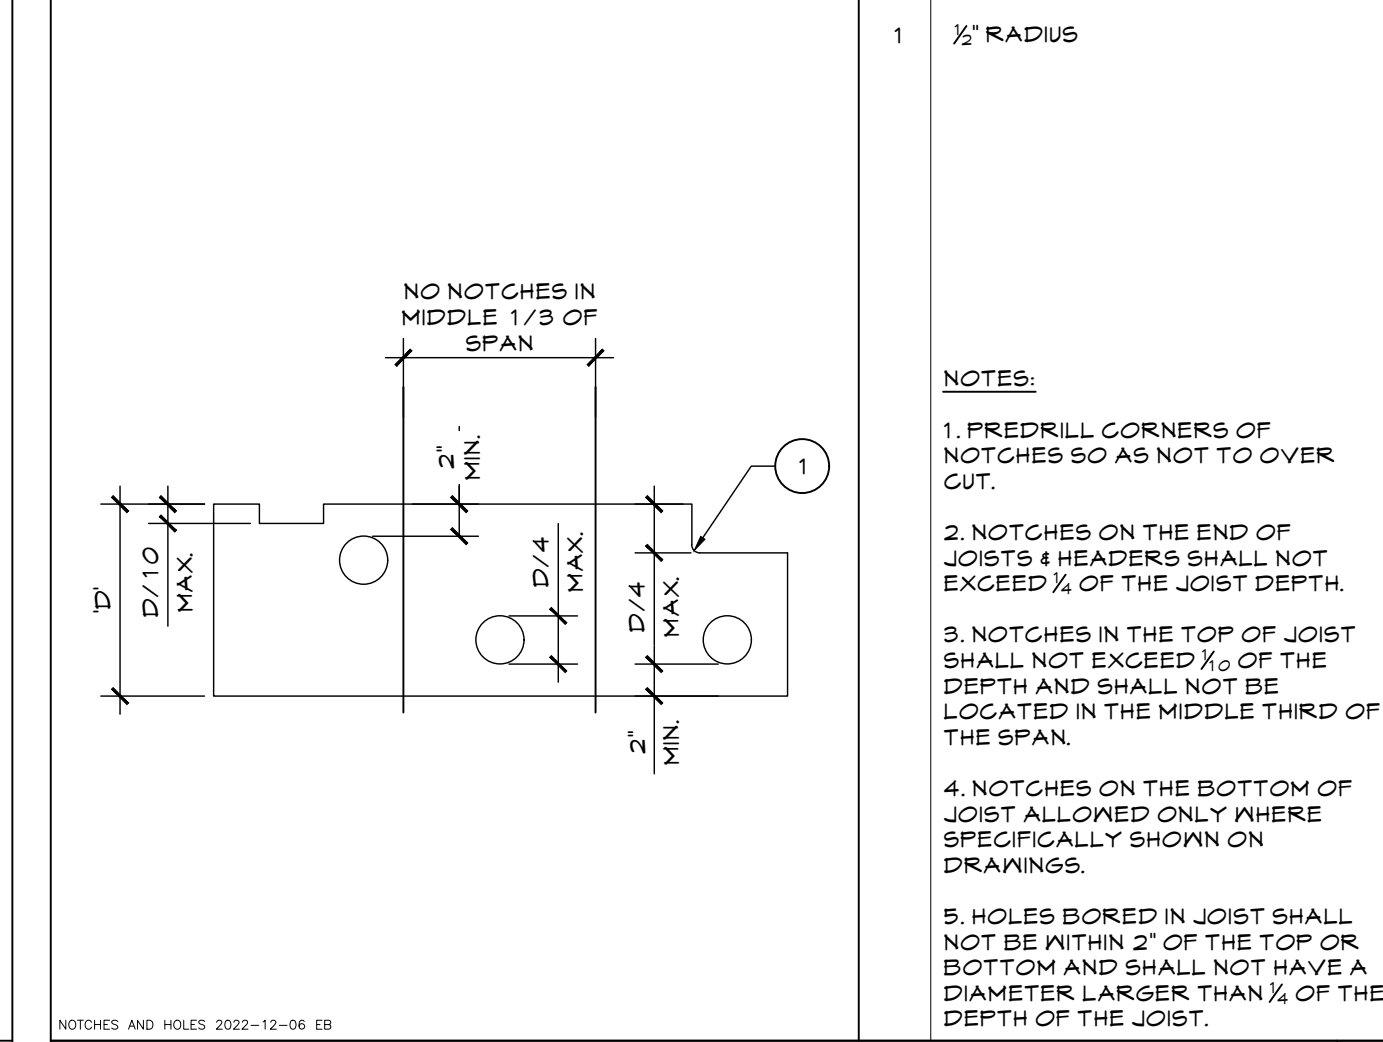


NOTCHES AND HOLES IN JOISTS SCALE: 1" = 1'-0" 3

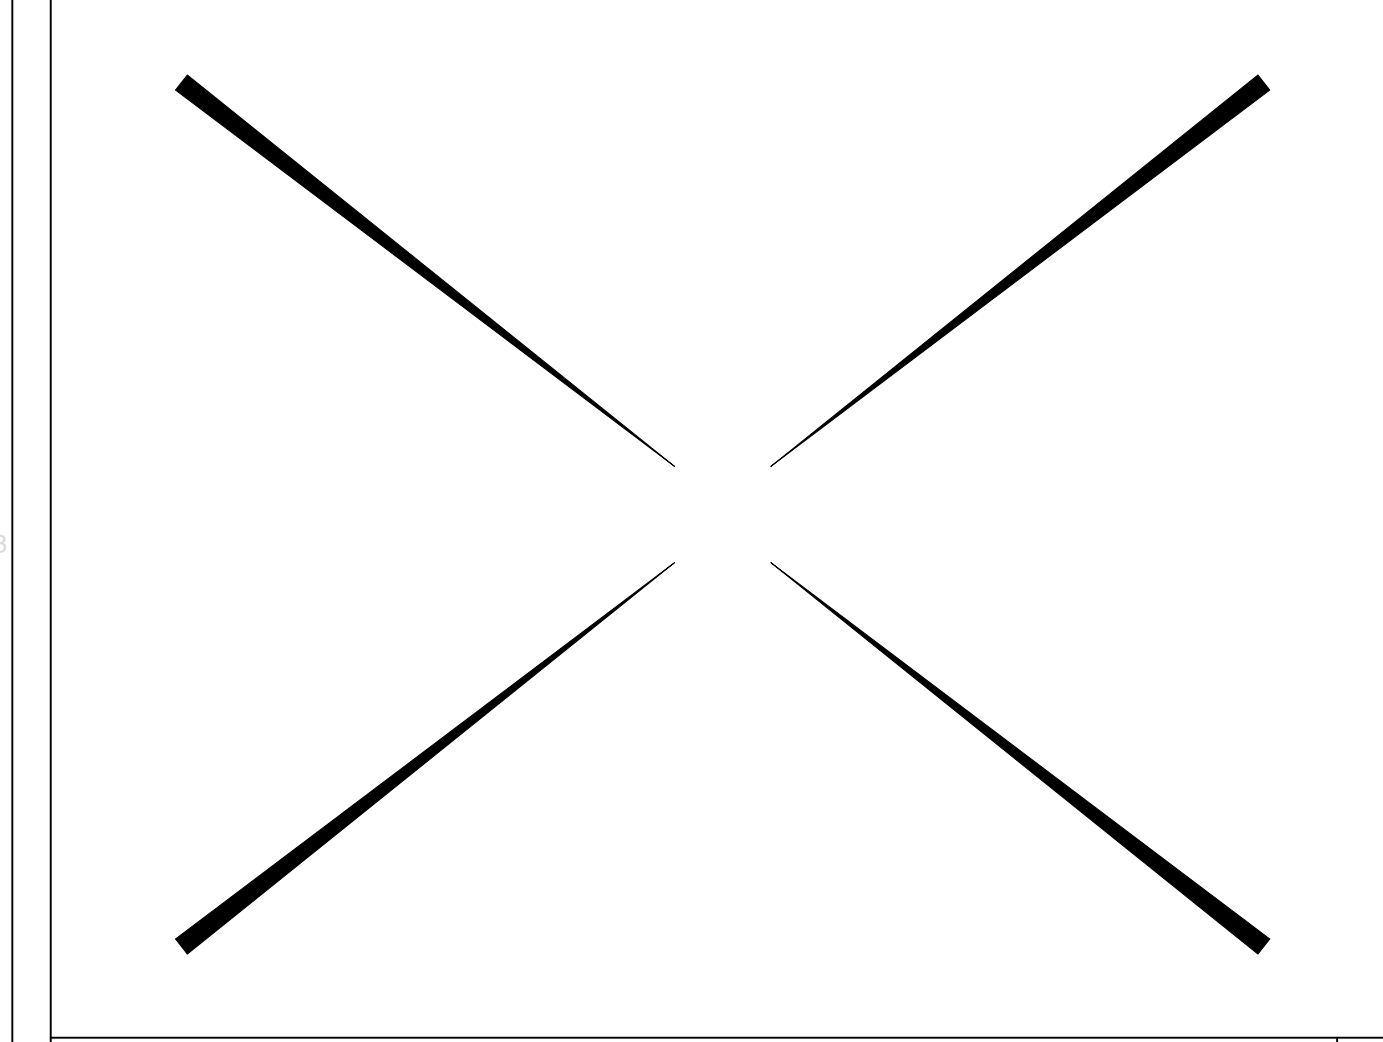


NOT USED SCALE: NONE 14

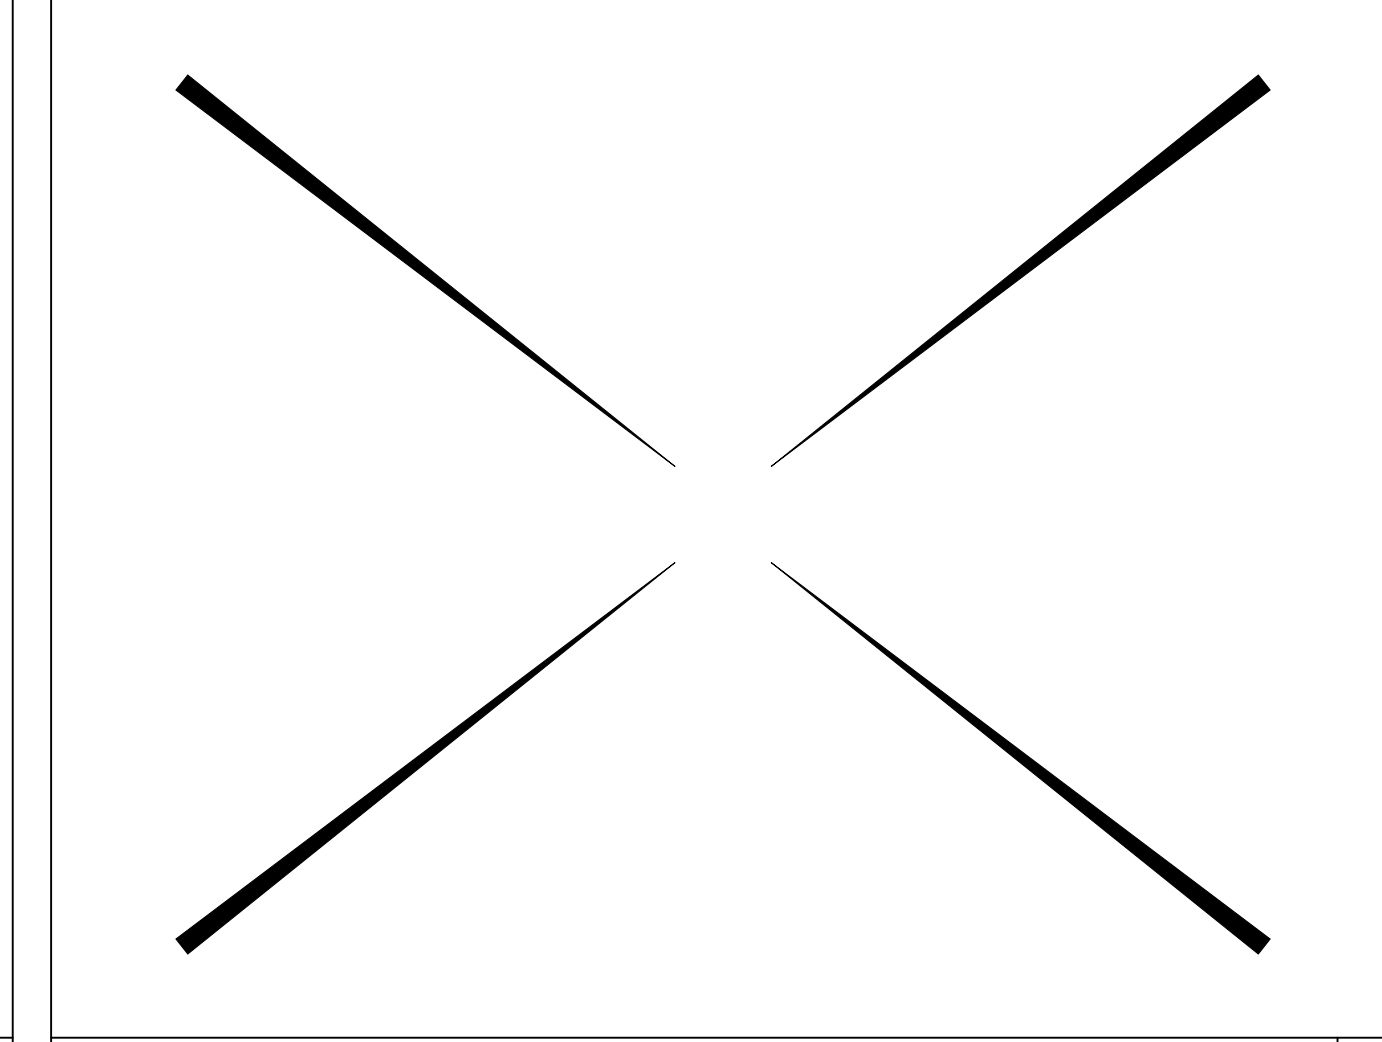


NOT USED SCALE: NONE 10

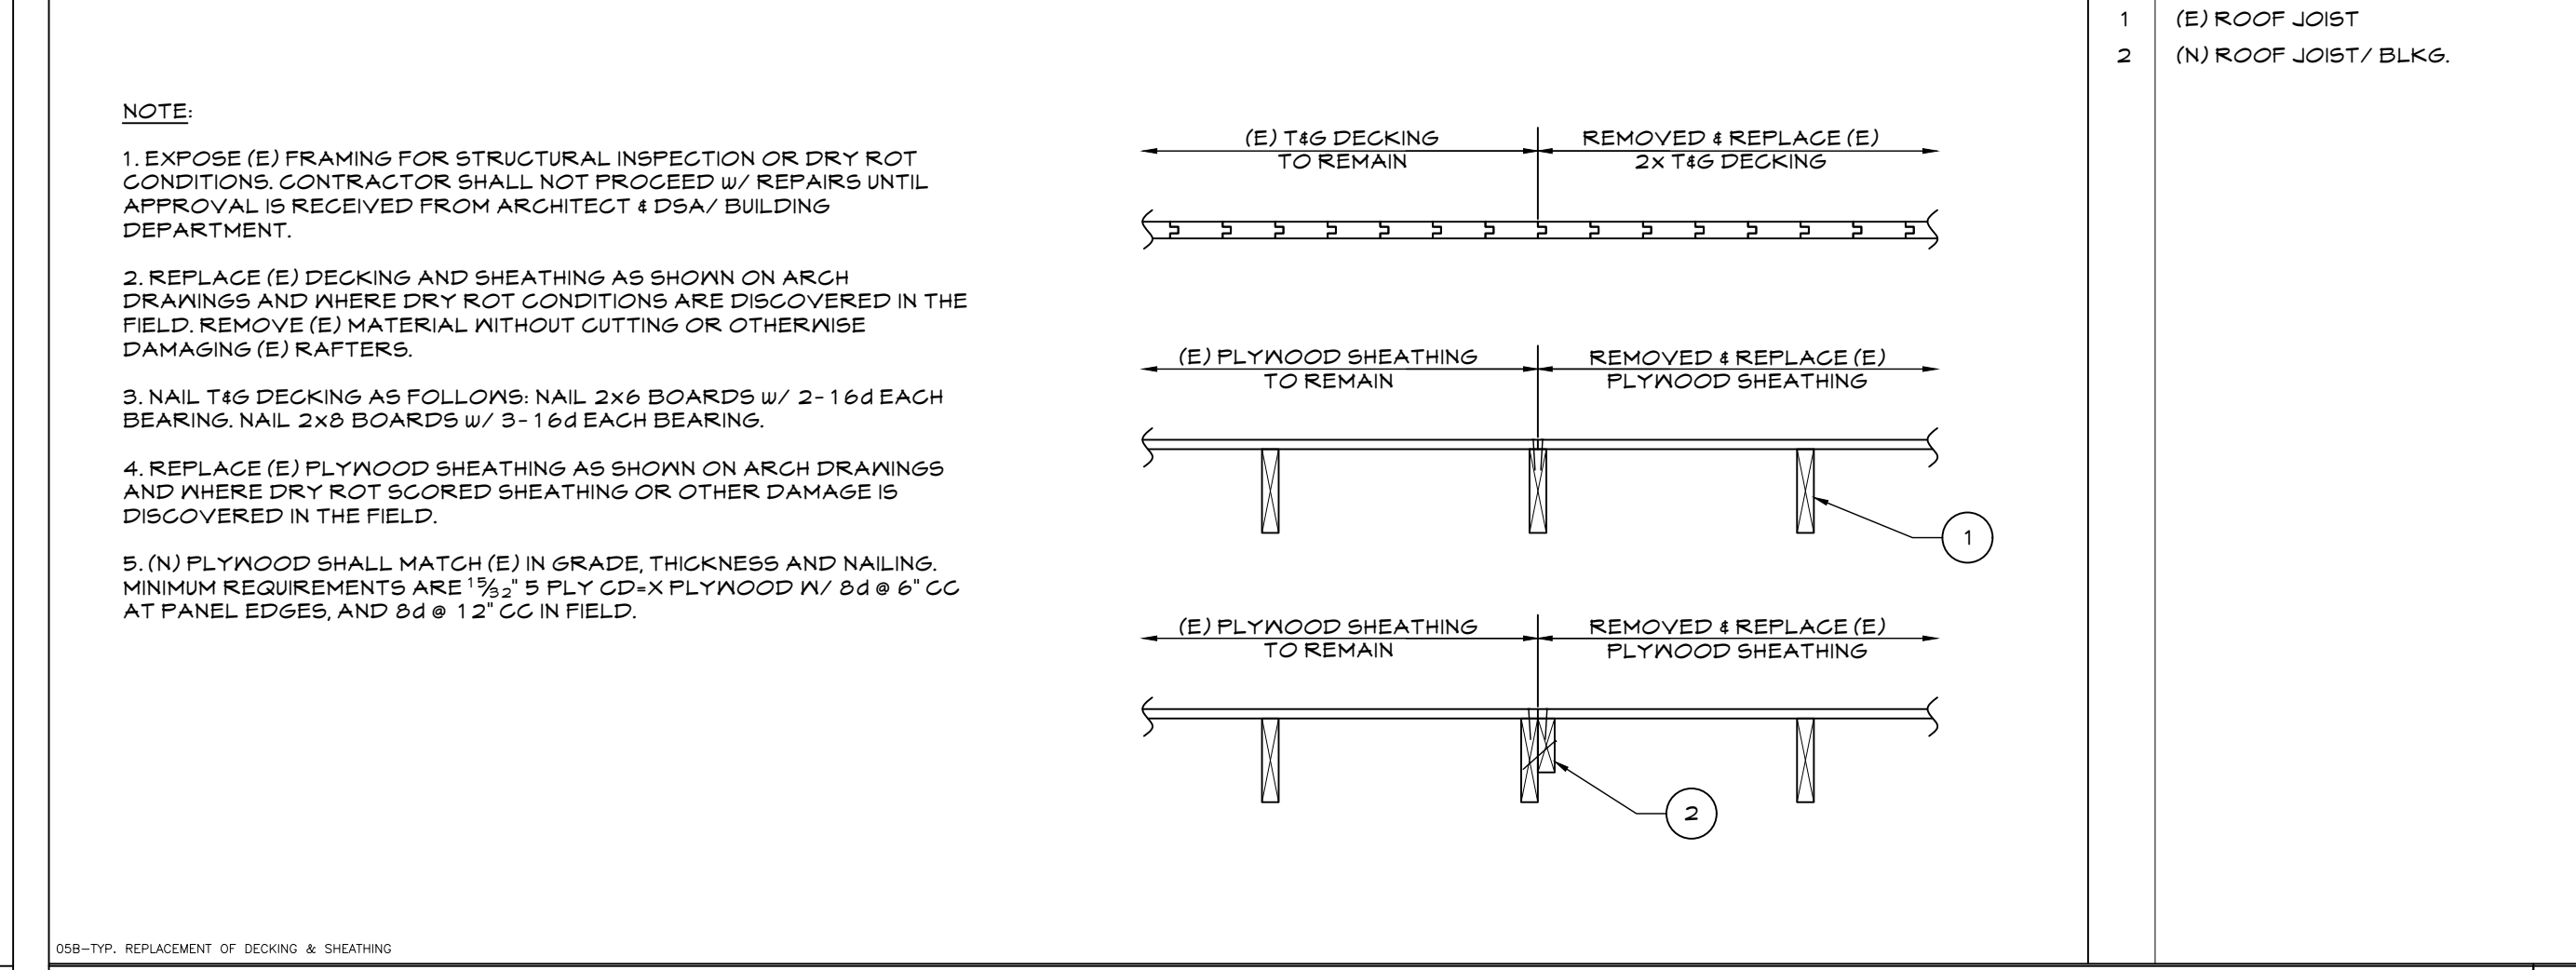


TYPICAL REPLACEMENT OF DECKING & SHEATHING SCALE: 1/2" = 1'-0" 2

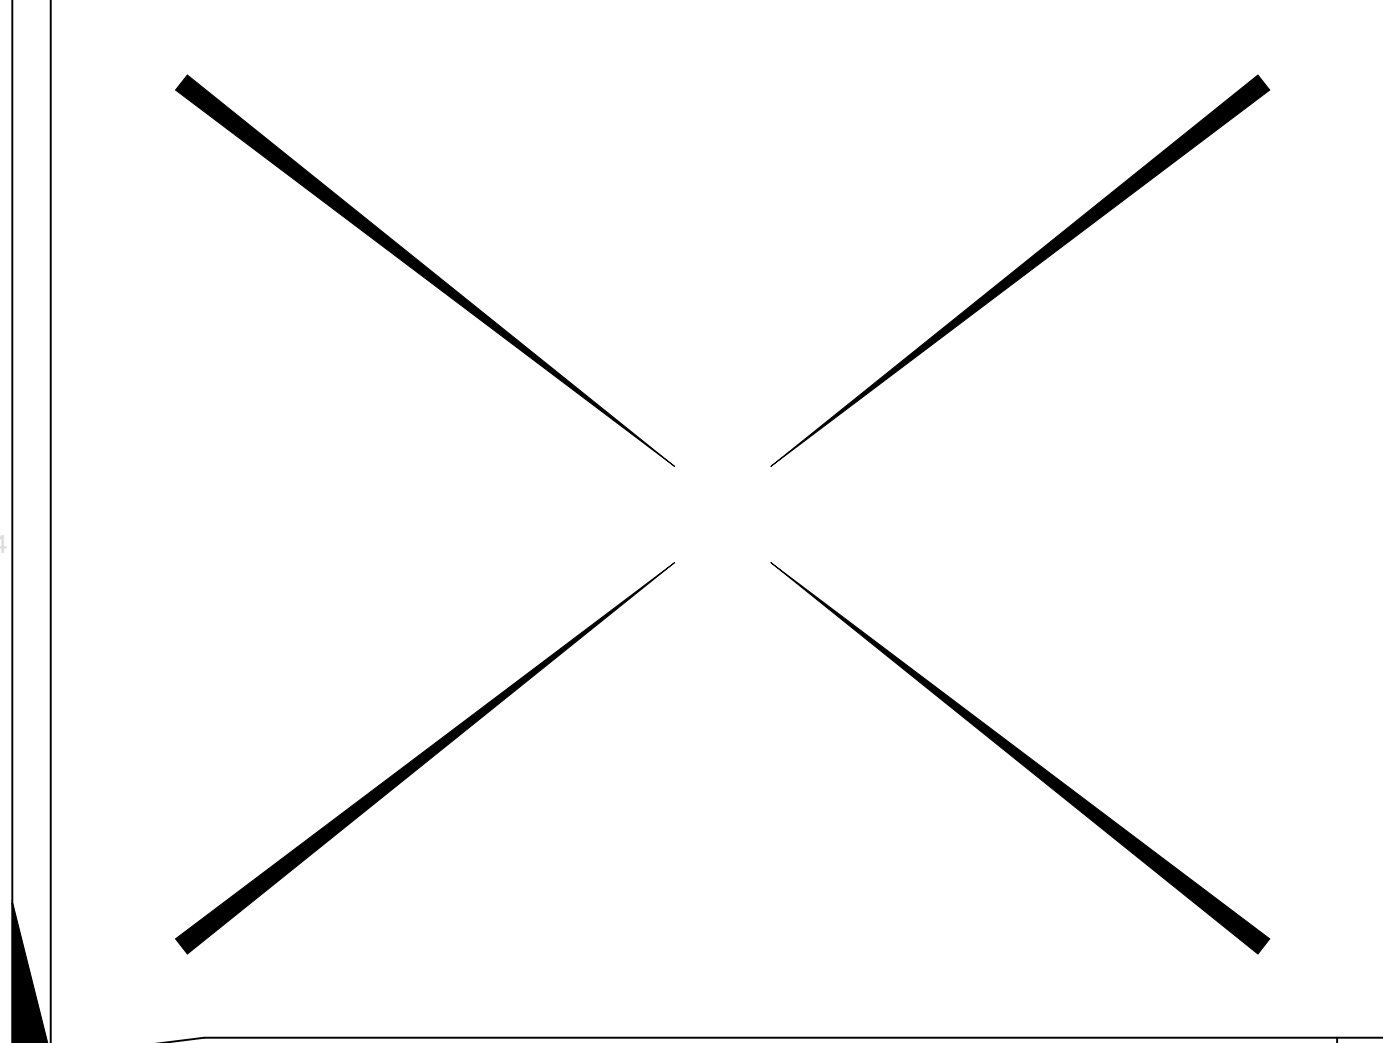


NOT USED SCALE: NONE 13

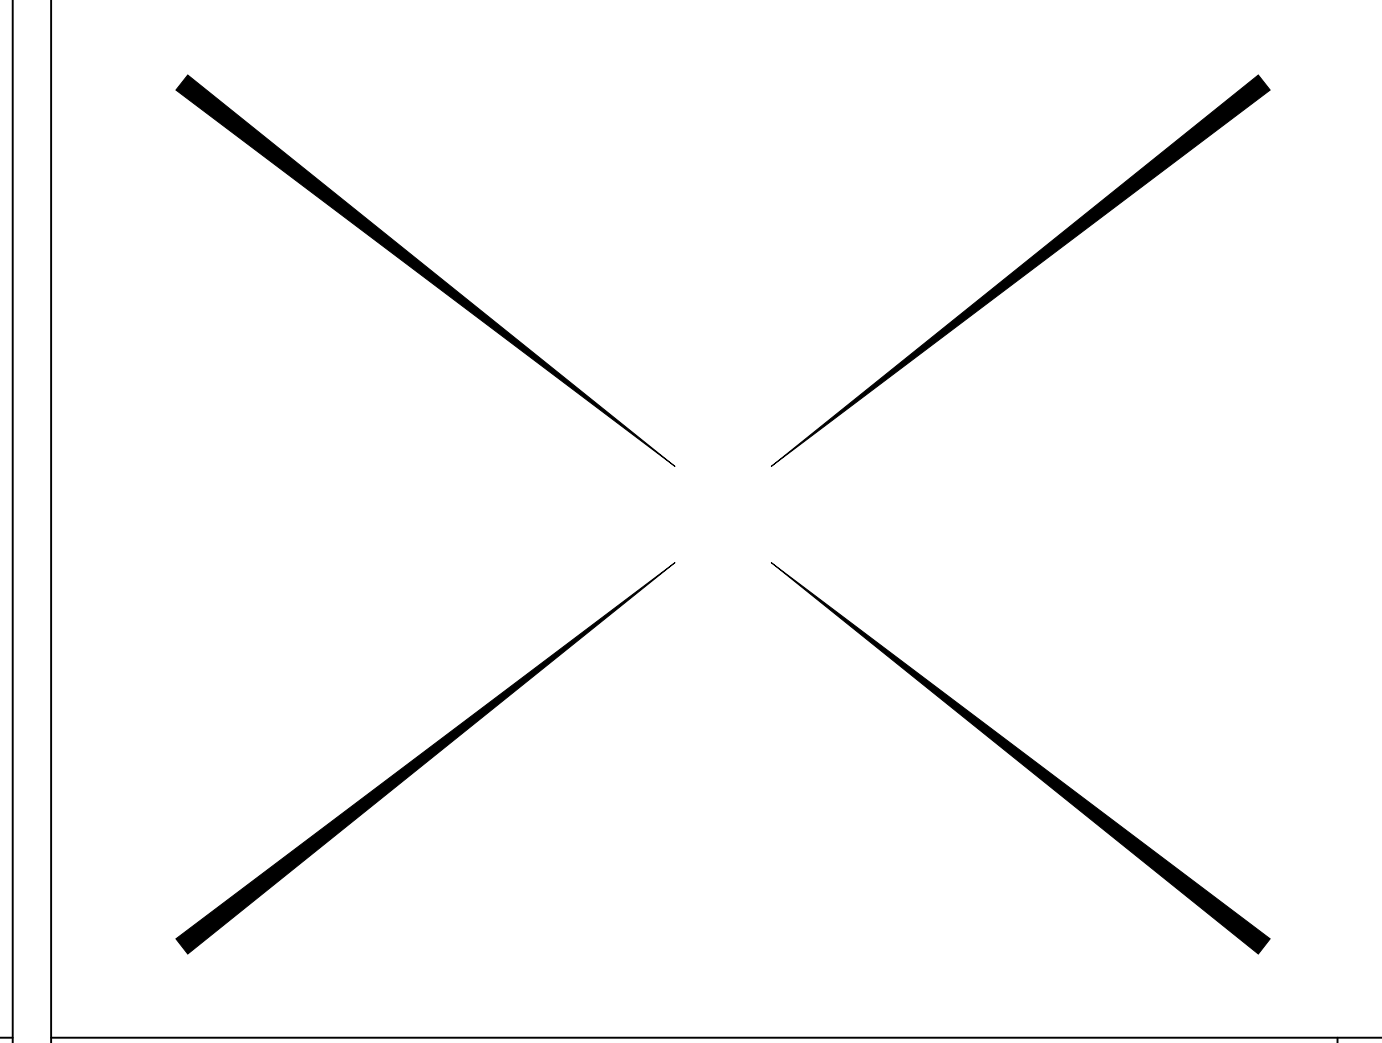

NOT USED SCALE: NONE 9

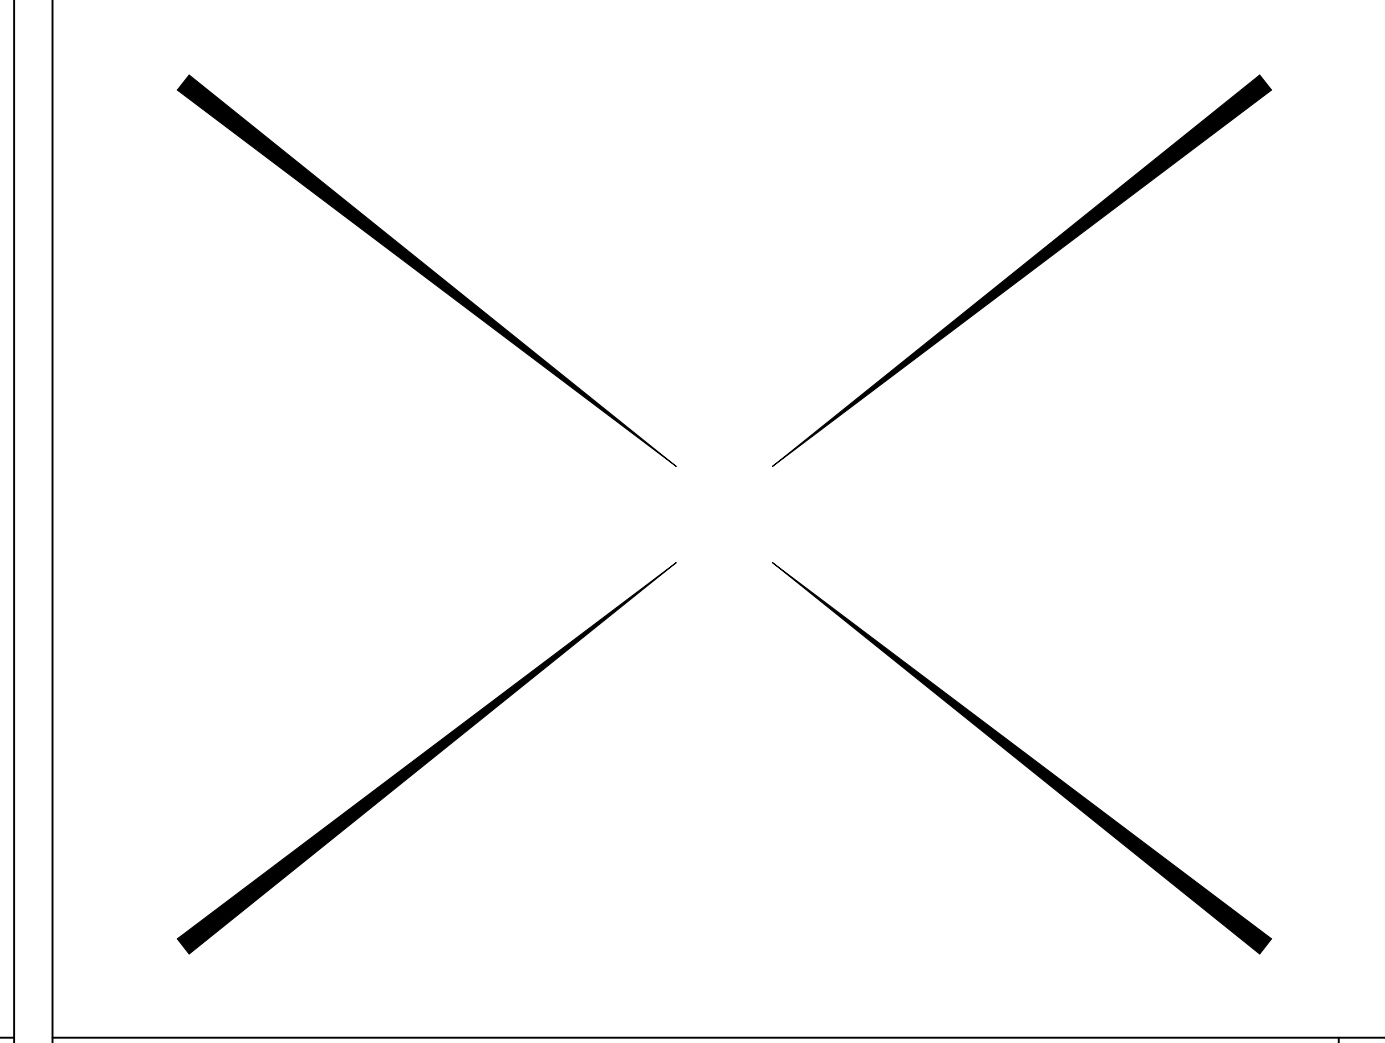

NOT USED SCALE: NONE 5

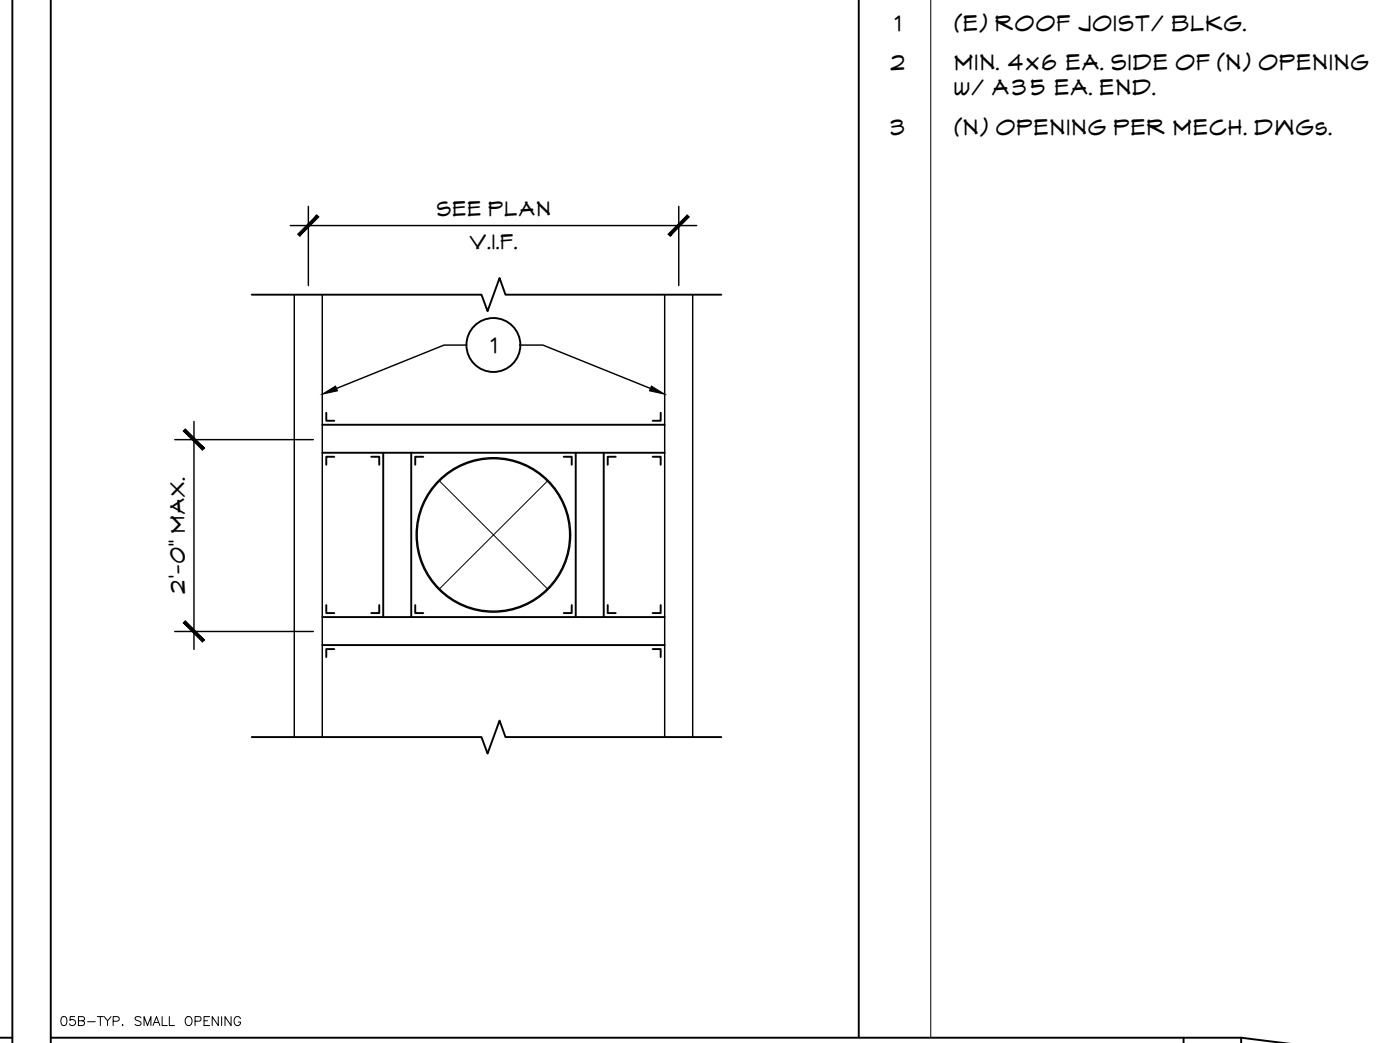

TYPICAL SMALL OPENING SCALE: 1/2" = 1'-0" 1

©2023 Synthesis Partners, LLC. All Rights Reserved. These record drawings have been prepared based upon information submitted, in part, by others. While this information is believed to be reliable, the Architect is not responsible for their accuracy, nor for errors or omissions which may have been incorporated into these documents as a result.



APPROVALS
PO Box 1900
Yuba City, CA 95992-1900
530.298.7298
www.spinc-arch.com

ARCHITECTURAL • COMMERCIAL • RESIDENTIAL • INTERIOR • CONSTRUCTION MANAGEMENT



OWNER
Woodland Joint Unified School District
435 6th Street
Woodland, CA 95695

PROJECT
ADULT EDUCATION CENTER
CLASSROOM RENOVATIONS
575 Hays Street
Woodland, CA 95695

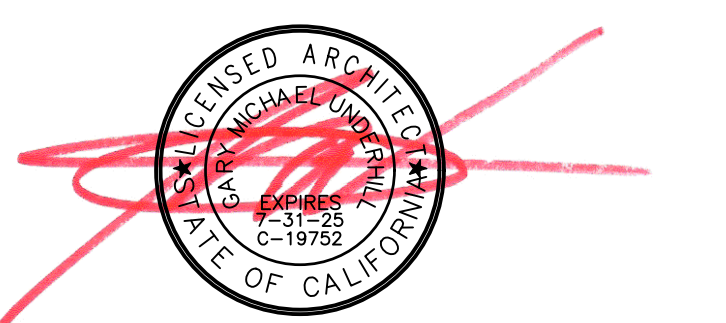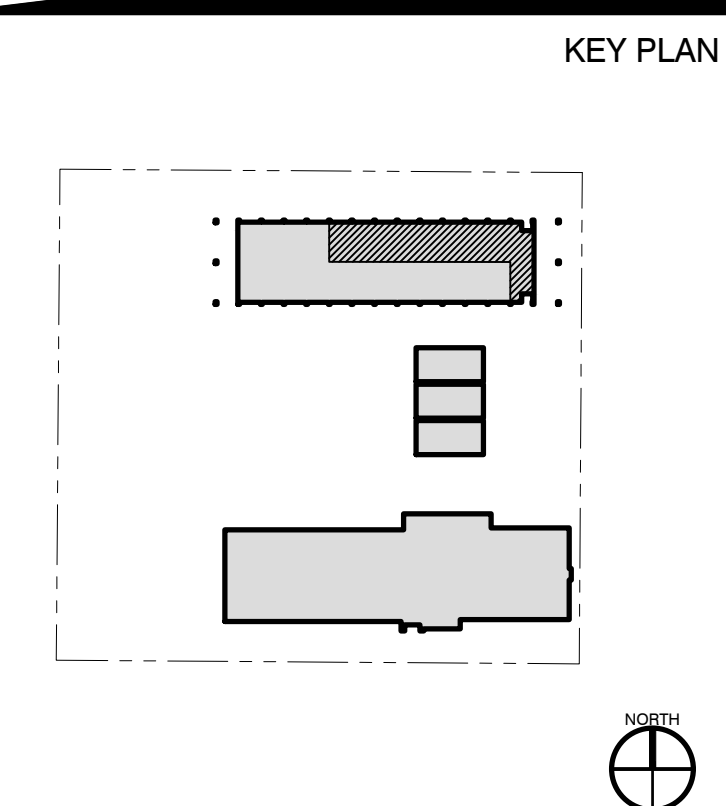

NO.	REVISION DESCRIPTION	DATE

DETAILS & NOTES

DATE 2023-03-28
PROJECT NO. 21-W04-01
S2.2

CAPTRATE SOLO FILTERS

CAPTRATE FILTERS ARE BUILT IN COMPLIANCE WITH:

- NSF A99
- NSF STANDARD #2
- UL STANDARD #1046
- INT. MECH. CODE (IMC)

SPECIFICATION: CAPTRATE GREASE-STOP SOLO FILTER

THE CAPTRATE GREASE-STOP SOLO FILTER IS A SINGLE-STAGE FILTER FEATURING A UNIQUE S-Baffle DESIGN IN CONJUNCTION WITH A SLOTTED REAR Baffle DESIGN TO DELIVER EXCEPTIONAL FILTRATION EFFICIENCY.

FILTER IS CONSTRUCTED OF 430 STAINLESS STEEL, AND SIZED TO FIT INTO STANDARD 2-INCH DEEP HOOD CHANNELS.

UNITS SHALL INCLUDE STAINLESS STEEL HANDLES AND A FASTENING DEVICE TO SECURE THE TWO COMPONENTS WHEN ASSEMBLED.

**GREASE EXTRACTION EFFICIENCY PERFORMANCE SHALL REMOVE AT LEAST 75% OF GREASE PARTICLES FIVE MICRONS IN SIZE, AND 90% GREASE PARTICLES SEVEN MICRONS IN SIZE AND LARGER, WITH A CORRESPONDING PRESSURE DROP NOT TO EXCEED 1.0 INCHES OF WATER GAUGE.

NOMINAL SIZE (H x W)	ACTUAL DIMENSIONS (H x W x D)	FREE AREA (SQ. FEET)	WEIGHT (POUNDS)	VELOCITY (FEET PER MINUTE)	STATIC PRESSURE (WATER GAUGE)
20 x 20	18.58" x 18.58" x 1.73"	2.26	11	100	0.25
20 x 10	18.58" x 15.58" x 1.73"	1.78	8.9	125	0.35
18 x 20	16.58" x 18.58" x 1.73"	1.78	8.1	100	0.45
18 x 10	16.58" x 15.58" x 1.73"	1.39	7.4	175	0.75
12 x 20	11.58" x 18.58" x 1.73"	1.23	6.8	200	0.90
12 x 10	11.58" x 15.58" x 1.73"	0.98	5.6	255	1.00
10 x 20	8.58" x 18.58" x 1.73"	1.03	5.2	260	1.30
10 x 10	8.58" x 15.58" x 1.73"	0.78	4.6	275	1.50

CAPTIVE-AIRE HOODS ARE BUILT IN COMPLIANCE WITH:

- NFPA 99B
- NSF
- ETL Listed
- CALIFORNIA MECHANICAL CODE
- INTERNATIONAL MECHANICAL CODE

BUILDING CODES

HOOD CORNER HANGING ANGLE (HARDWARE BY INSTALLER)

ASSEMBLY INSTRUCTIONS

HANGING ANGLE MUST BE SUPPORTED WITH 1/2" - 13 TPI GRADE 5 (MINIMUM) ALL-THREAD, SANDWICH HANGING ANGLE AND CEILING ANCHOR POINTS WITH 1/2" GRADE 5 (MINIMUM) STEEL FLAT WASHERS AND 1/2" - 13 TPI GRADE 5 (MINIMUM) HEX NUTS AS SHOWN. MUST USE DOUBLE HEX NUT CONFIGURATION BENEATH HOOD HANGING ANGLE AND ABOVE CEILING ANCHORS. MAINTAIN 1/4" OF EXPOSED THREADS BENEATH BOTTOM HEX NUT. TORQUE ALL HEX NUTS TO 37 FT-LBS.

ND-2 HANGING ANGLE DETAIL

HANGING ANGLES WILL BE LOCATED IN THE FOLLOWING LOCATIONS FOR WALL CANOPIES

HOOD STYLE	DIM FROM REAR	DIM FROM FRONT SIDES (24" High Hood)	DIM FROM FRONT SIDES (24" High Hood)
ND-2 (W/ Exhaust only)	4.125"	2.25"	2.25"
VHIB (-B)	2.25"	2.25"	2.25"

ALL OTHER HOOD MODELS CONTACT CAPTIVE AIRE FOR HANGING ANGLE LOCATIONS

HANGING ANGLE LOCATIONS

HOOD OPTIONS

HOOD NO	TAG	OPTION
1	H-1	FIELD WRAPPER 17.00" HIGH FRONT, LEFT, RIGHT, BACKSPASH 80.00" HIGH X 192.00" LONG 430 SS VERTICAL.

PERFORATED SUPPLY PLENUM(S)




HOOD NO	TAG	POS	LENGTH	WIDTH	HEIGHT	TYPE	RISER(S)			
							WIDTH	LENG	DIA	CFM
1	H-1	Front	192"	16"	6"	MUA	12"	28"	746	0.209"
							12"	28"	746	0.209"
							12"	28"	746	0.209"
							12"	28"	746	0.209"

HOOD INFORMATION - JOB#5668675

HOOD NO	TAG	MODEL	MANUFACTURER	LENGTH	MAX COOKING TEMP	TYPE	APPLIANCE DUTY	DESIGN CFM/FIT	TOTAL EXH CFM	EXHAUST PLENUM RISER(S)				TOTAL SUPPLY CFM	HOOD CONSTRUCTION	HOOD CONFIG			
										WIDTH	LENG	HEIGHT	DIA			CFM	VEL	SP	END TO END
1	H-1	5424 ND-2-PSP-F	CAPTIVEAIRE	15' 0"	600 DEG	I	HEAVY	240	3600	14"	18"	4"	3600	2057	-1.272"	2985	430 SS WHERE EXPOSED	ALONE	ALONE
2	H-2	4224 VHB-G	CAPTIVEAIRE	3' 7"	700 DEG	II	N/A	150	538	10"	10"	4"	538	986	-0.073"	0	430 SS 100%	ALONE	ALONE

HOOD INFORMATION

HOOD NO	TAG	FILTER(S)				LIGHT(S)			UTILITY CABINET(S)				FIRE SYSTEM HANGING PIPING	HOOD WEIGHT			
		TYPE	QTY	HEIGHT	LENGTH	EFFICIENCY @ 7 MICRONS	QTY	TYPE	WIRE GUARD	LOCATION	SIZE	FIRE SYSTEM TYPE			SIZE	ELECTRICAL MODEL #	SWITCHES QUANTITY
1	H-1	CAPTRATE SOLO FILTER	11	20"	16"	85% SEE FILTER SPEC	4	RECESSED ROUND	NO	RIGHT	12"x54"x24"	ANSUL R-102	3.0	DCV-1111	1 LIGHT 1 FAN	YES	978 LBS
2	H-2						0									NO	136 LBS

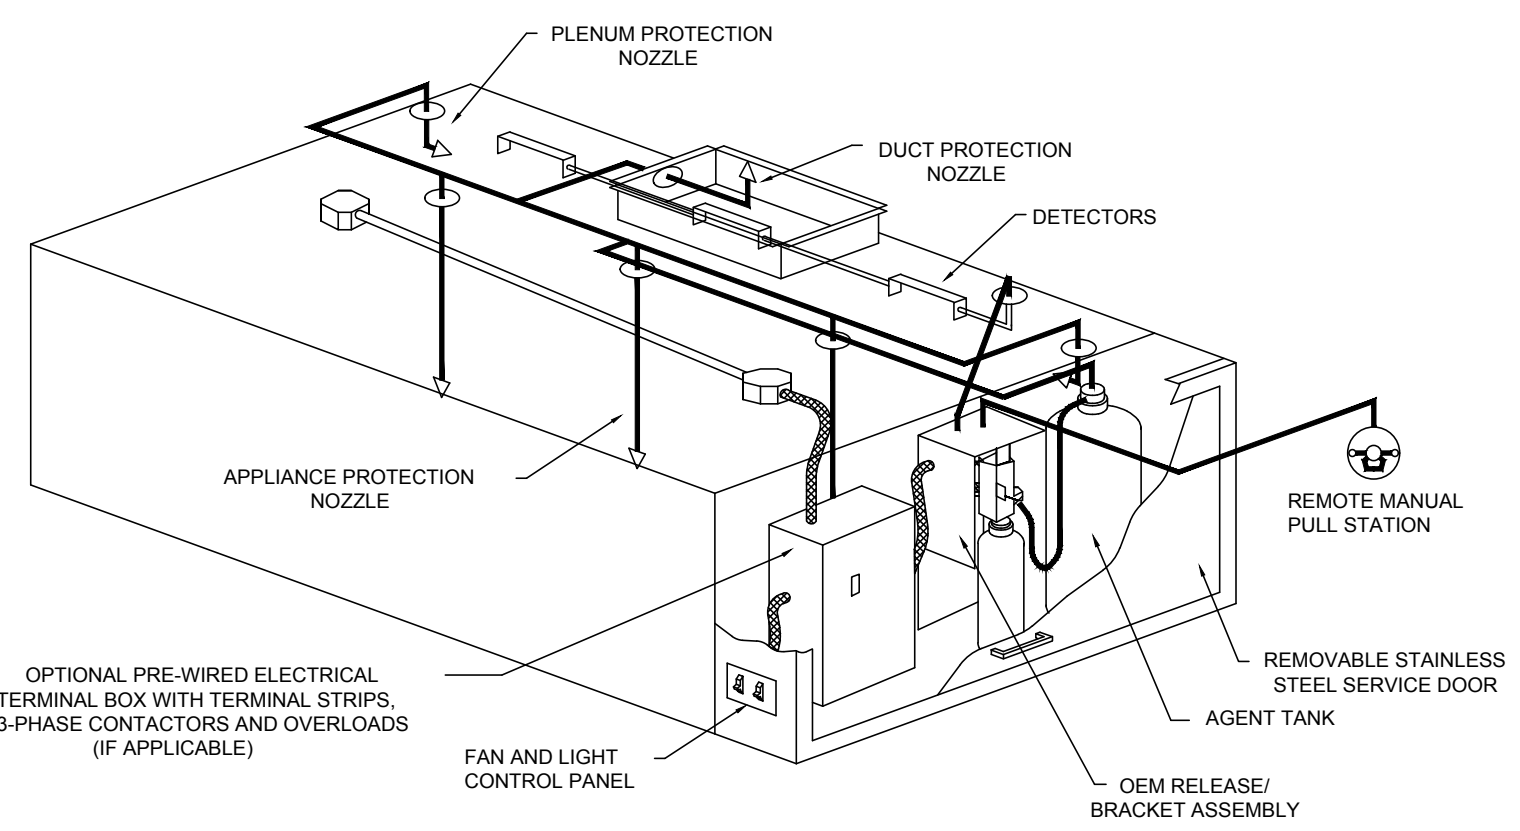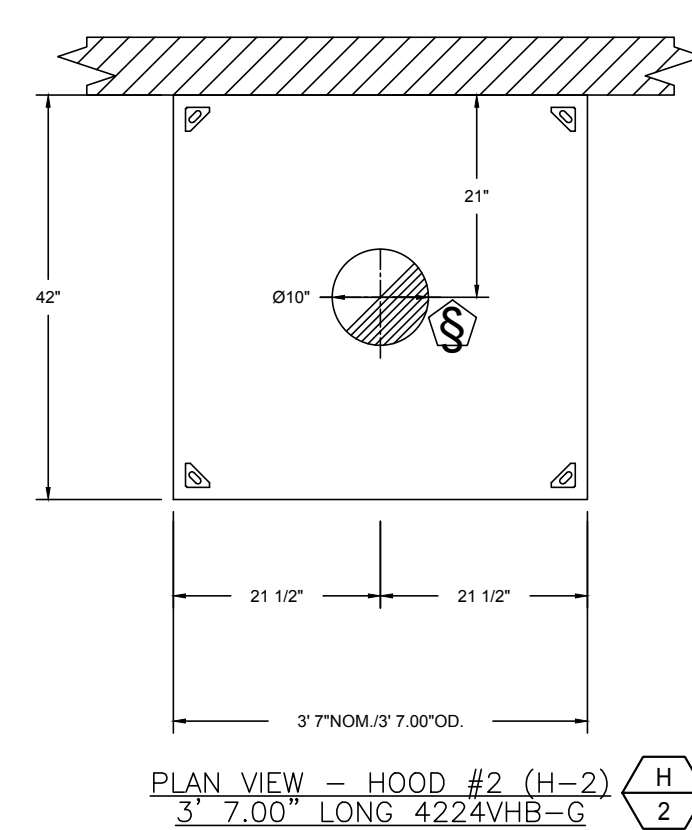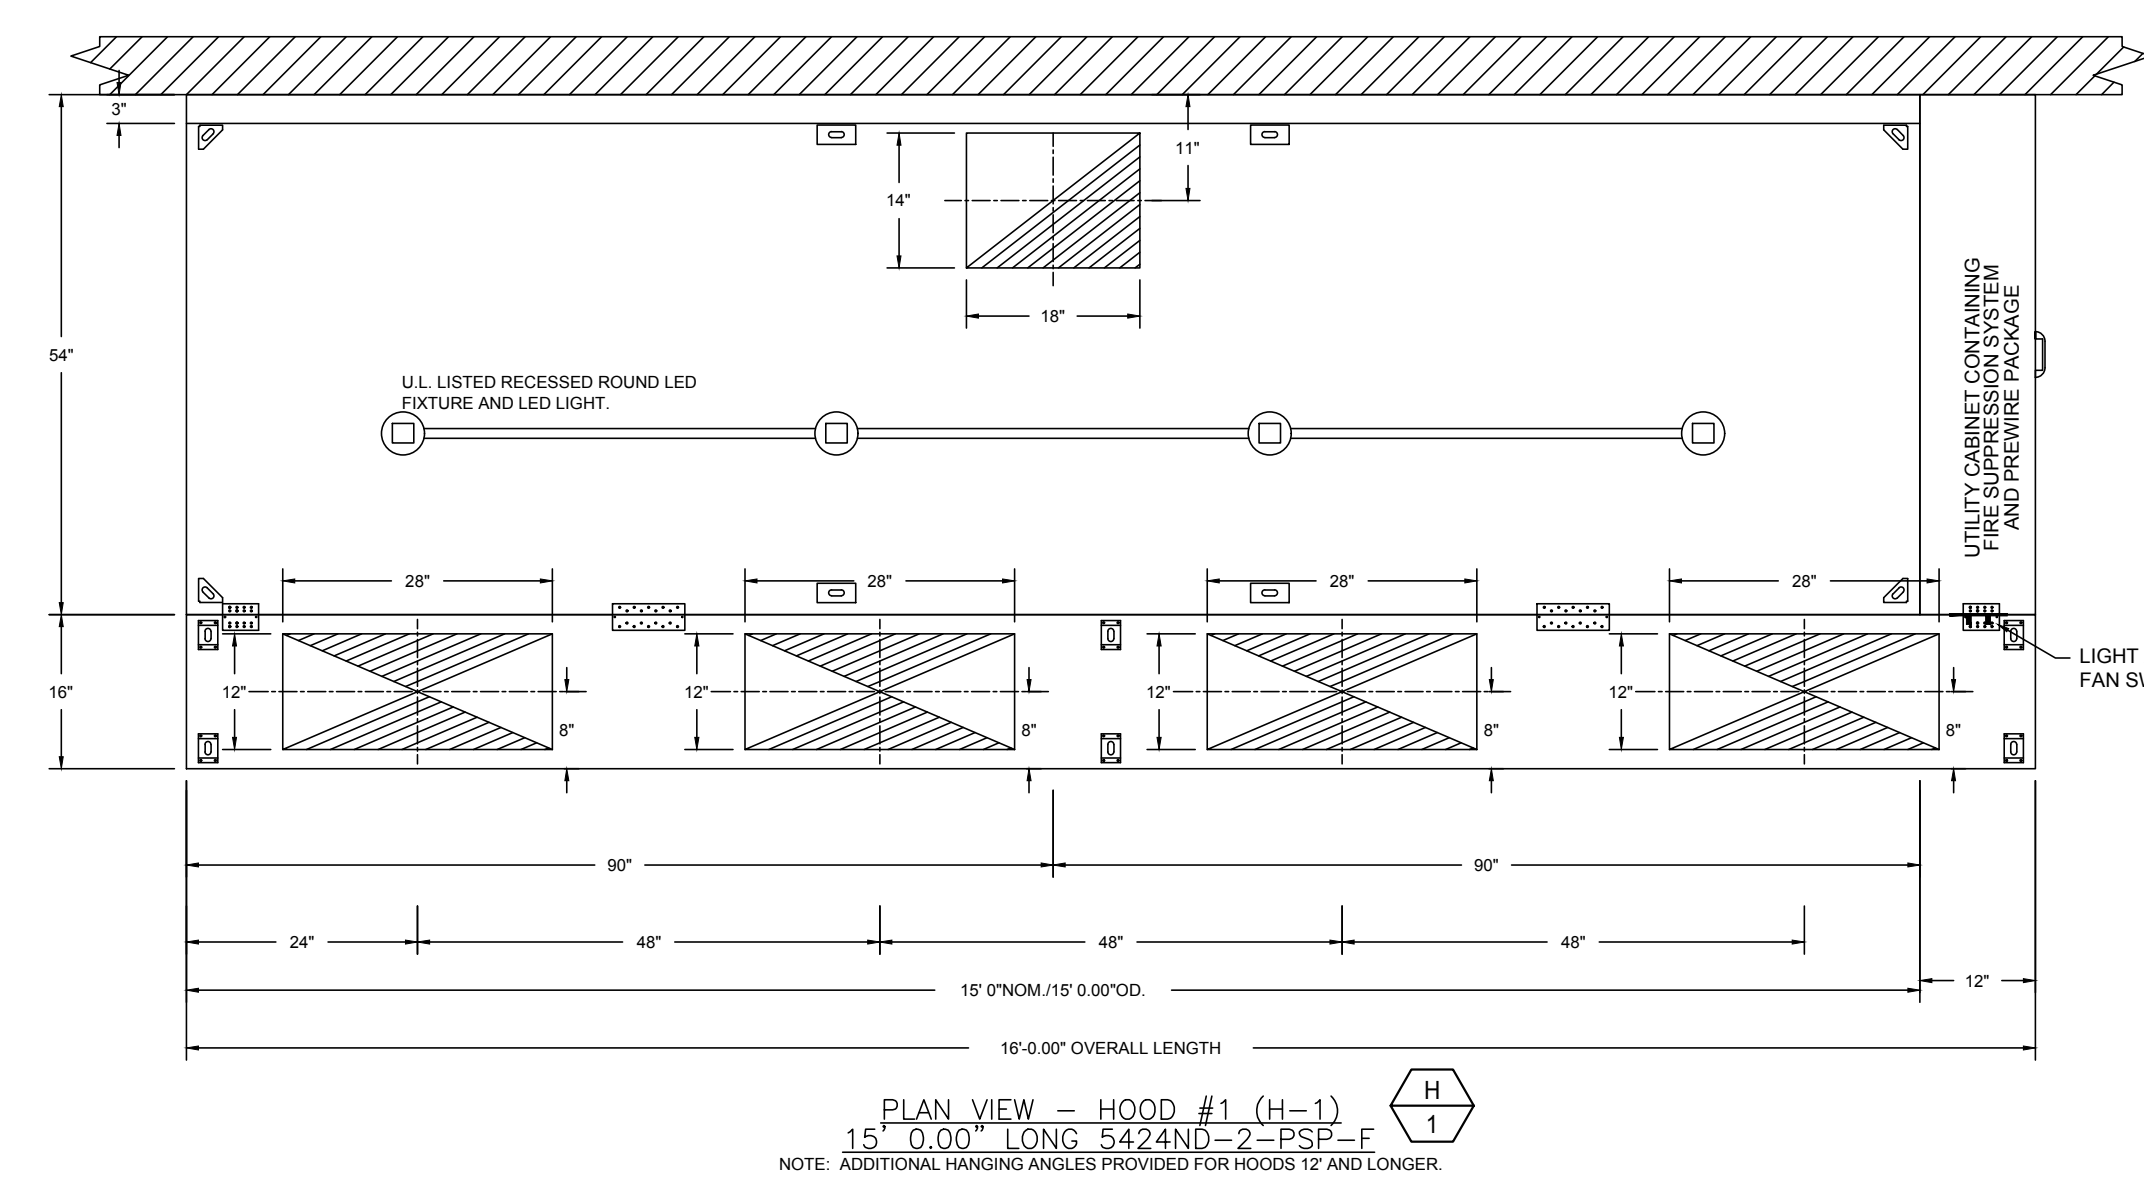

These products and others are available for demonstration at the Northern CA display center information or questions Contact--

Captive Aire Systems
1110 Burnett Ave, Suite G, Concord, CA, 94520
Phone: (925)982-1990 Fax: (925)566-8565
Email: reg92@captiveaire.com

REVISIONS

NO.	REVISION DESCRIPTION	DATE
1	ADDENDUM 2	2023/03/20

DATE: 3/9/2023

DWG.#: 5668675

DRAWN BY:

SCALE: 3/4" = 1'-0"

MASTER DRAWING

SHEET NO. 1

CAPTIVE

Northern California Office
1110 Burnett Ave, Suite G, Concord, CA, 94520 PHONE: (925) 982-1999 FAX: (925) 566-8565 EMAIL: reg92@captiveaire.com

APPROVALS

PO Box 1900
Yuba City, CA 95992-1900
530.298.7298
www.spinc-arch.com

ANALYTICAL • COMERCIAL • RESIDENTIAL • INTERIOR • CONSTRUCTION MANAGEMENT

SYNTHESIS PARTNERS, LLC
Managers • Architects

WESTON & ASSOCIATES
MECHANICAL ENGINEERS
601 UNIVERSITY AVE., SUITE 260 | SACRAMENTO, CA 95825
WESTON & ASSOCIATES #22-033

OWNER

Woodland Joint Unified School District
435 6th Street
Woodland, CA 95695

PROJECT

CLASSROOM CONVERSIONS
at
WOODLAND EDUCATION CENTER
575 Hays Street
Woodland, CA 95695

KEY PLAN




DATE: 2022-07-24
PROJECT NO.: 21-W04-01

M0.2

- FAN #5 A2-RT-200-20D - HEATER (MAU-1)
- INDIRECT BENT TUBE GAS FIRED HEATER WITH 20" MIXED FLOW DIRECT DRIVE FAN, 1 FURNACE, ELECTRONIC FULL MODULATION, CONSTANT 80% EFFICIENCY, AND 1 MAX TURN-DOWN FOR HQ, 10:1 MAX TURN-DOWN FOR LP, STAINLESS STEEL BURNER AND HEAT EXCHANGER.
 - EVAP COOLER (LPO CELDEK) - WINTAKE HOOD WIEZ FILTERS.
 - SIDE DISCHARGE - AIR FLOW RIGHT - LEFT.
 - GAS PRESSURE GAUGE, 0 TO 10 INCHES WC, 2.5" DIAMETER, 1/4" THREAD SIZE.
 - GAS PRESSURE GAUGE, 0 TO 10 INCHES WC, 2.5" DIAMETER, 1/8" THREAD SIZE, REAR THREAD.
 - SEPARATE 120V ELECTRICAL CONNECTION FOR ALL RT HEATERS WITH 1 MODULE FOR STANDING POWER. 120V MUST BE RUN BY ELECTRICIAN FROM BUILDING PANEL TO MAU SWITCH.
 - MOTORIZED BACK DRAFT DAMPER 22 7/8" X 24" FOR SIZE 2 STANDARD & MODULAR HEATER UNITS W/EXTENDED SHAFT, STANDARD GALVANIZED CONSTRUCTION, 3/4" REAR FLANGE, LOW LEAKAGE, LF120S ACTUATOR INCLUDED.
 - LAFER CONTROL FOR RT EVAP.
 - FREESTATE PROTECTION DRAIN CONTROL KIT FOR EVAPORATIVE COOLERS. INCLUDES 3-WAY WATER SOLENOID VALVE 83160604 (SHIPPED LOOSE), PRESSURE SWITCH INSTALLED UPSTREAM OF 2WAY SOLENOID IN UNIT, BRASS TEE AND 2 NPT HALF INCH NIPPLES. FIELD WIRING REQUIRED BY OTHERS FOR 3-WAY VALVE. FOR BOTH CELDEK AND STANDARD V-BANK TYPE CONFIGURATIONS.
 - USED WITH SIZE 1 AND SIZE 2 SIDE DISCHARGE RT MODULES.
 - SEPARATE 120VAC WIRING PACKAGE FOR MAKE-UP AIR UNITS. OPTION MUST BE SELECTED WHEN MOUNTING VFD IN PREWIRE PANEL OR WITH DCV PACKAGE. PROVIDES SEPARATE 120VAC INPUT TO SUPPLY FAN. THIS 120V SIGNAL MUST BE RUN BY ELECTRICIAN FROM DCV TO MUA SWITCH.
 - HINGED DOUBLE WALL INSULATED DOOR ASSEMBLY (BURNER/LOWER REAR SECTION).
 - 2 YEAR ENTIRE UNIT PARTS WARRANTY, 25 YEAR STAINLESS STEEL FURNACE PARTS WARRANTY
 - US PATENT #77119162.

*NOTE: SUPPLY DUCT MUST BE INSTALLED TO MEET SMACNA STANDARDS. A MINIMUM STRAIGHT DUCT LENGTH MUST BE MAINTAINED DOWNSTREAM OF UNIT DISCHARGE AS OUTLINED IN AMCA PUBLICATION 201. WHEN USING RECTANGULAR DUCTWORK, ELBOWS MUST BE RADIUS THROAT. RADIUS BACK WITH TURNING VANES. FLEXIBLE DUCTWORK AND SQUARE THROAT SQUARE BACK ELBOWS SHOULD NOT BE USED. ANY TRANSITION AND/OR TURNS IN THE DUCTWORK WILL CAUSE SYSTEM EFFECT. SYSTEM EFFECT WILL PRACTICALLY INCREASE STATIC PRESSURE AND REDUCE AIRFLOW. DO NOT RELY ON UNIT TO SUPPORT DUCT IN ANY WAY. FAILURE TO PROPERLY SIZE DUCTWORK MAY CAUSE SYSTEM EFFECTS AND REDUCE PERFORMANCE OF THE EQUIPMENT. SUGGESTED STRAIGHT DUCT SIZE IS 26" X 26".

SUPPLY SIDE HEATER INFORMATION:
 WINTER TEMPERATURE = 34°F, TEMP. RISE = 41°F.
 BTU/h CALCULATED OFF ACTUAL AIR DENSITY
 OUTPUT BTU/h AT ALTITUDE OF 0 FT = 153705
 INPUT BTU/h AT ALTITUDE OF 0 FT = 169759
 OUTPUT BTU/h AT ALTITUDE OF 68 FT = 153327
 INPUT BTU/h AT ALTITUDE OF 68 FT = 169293

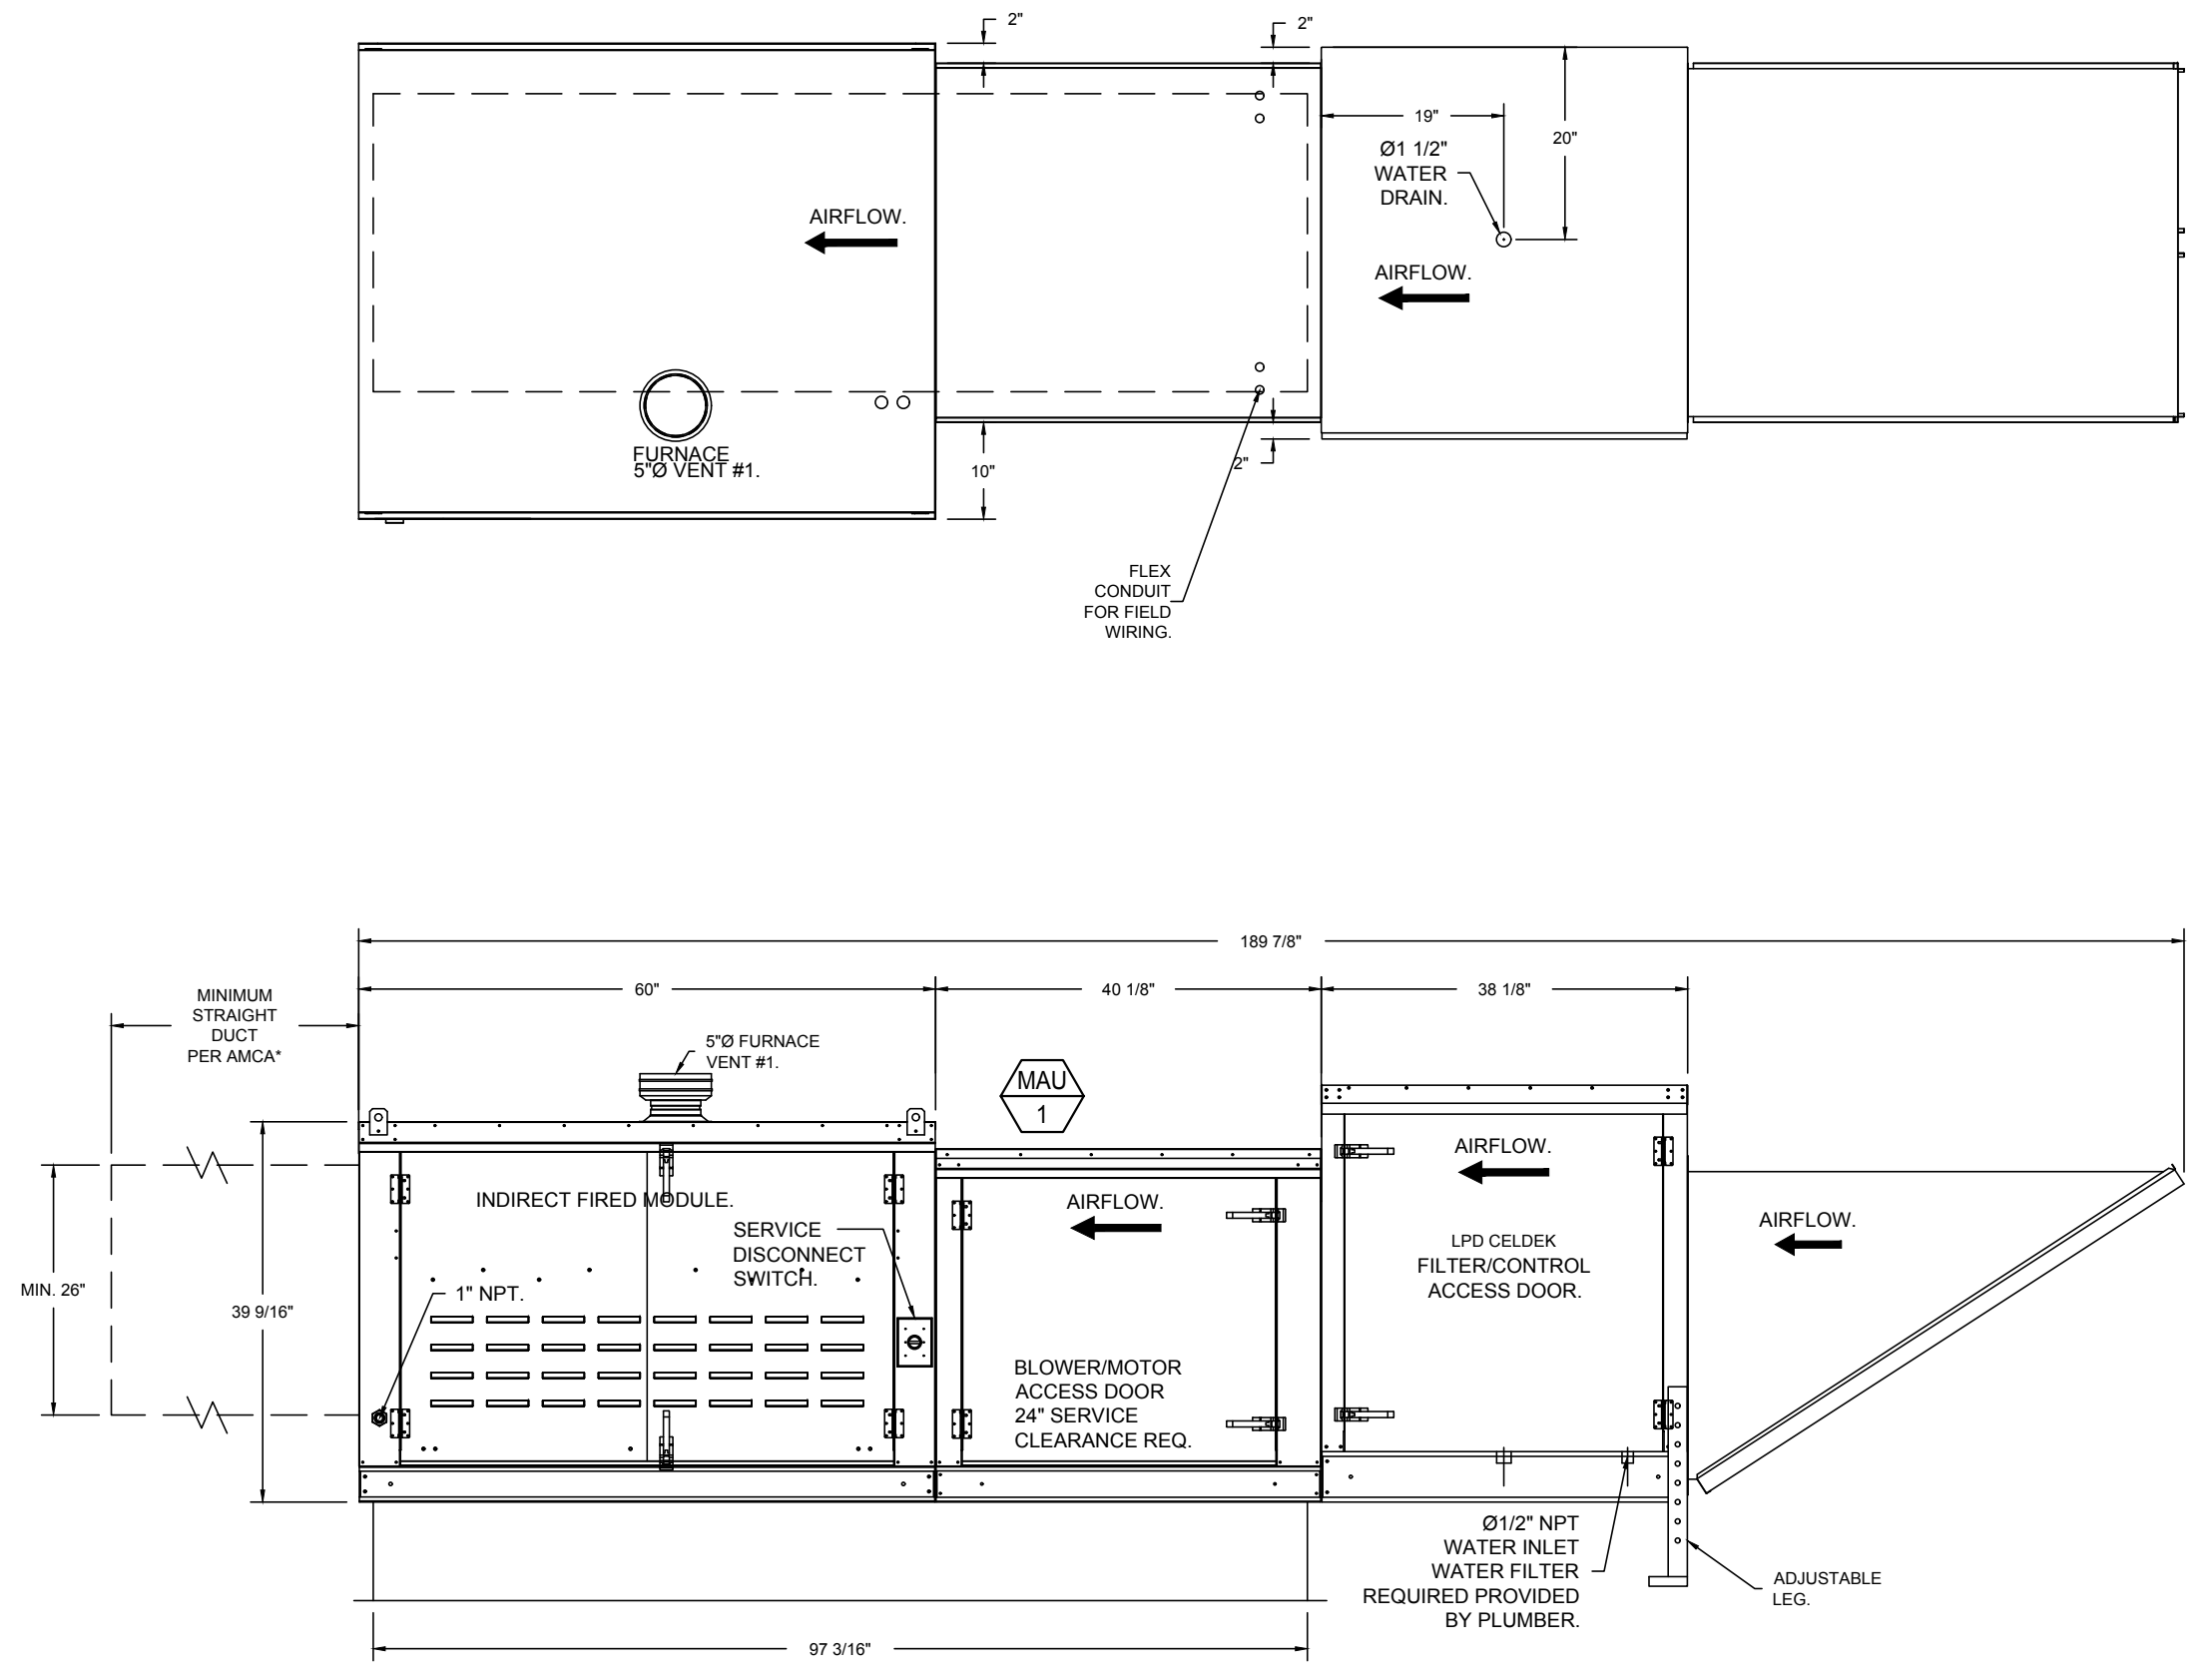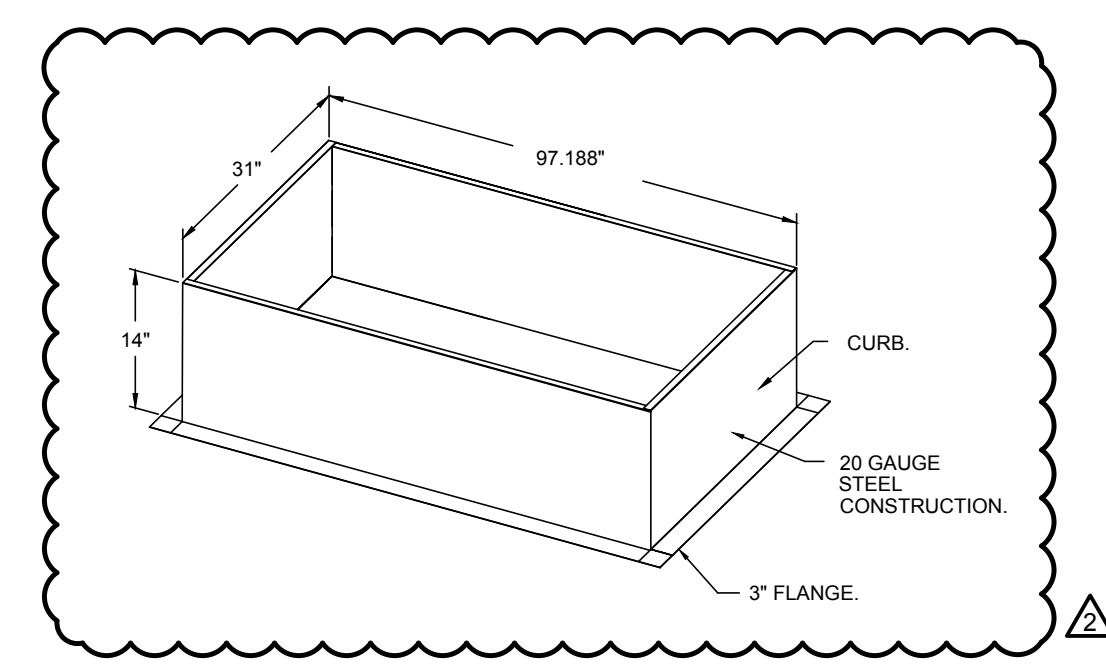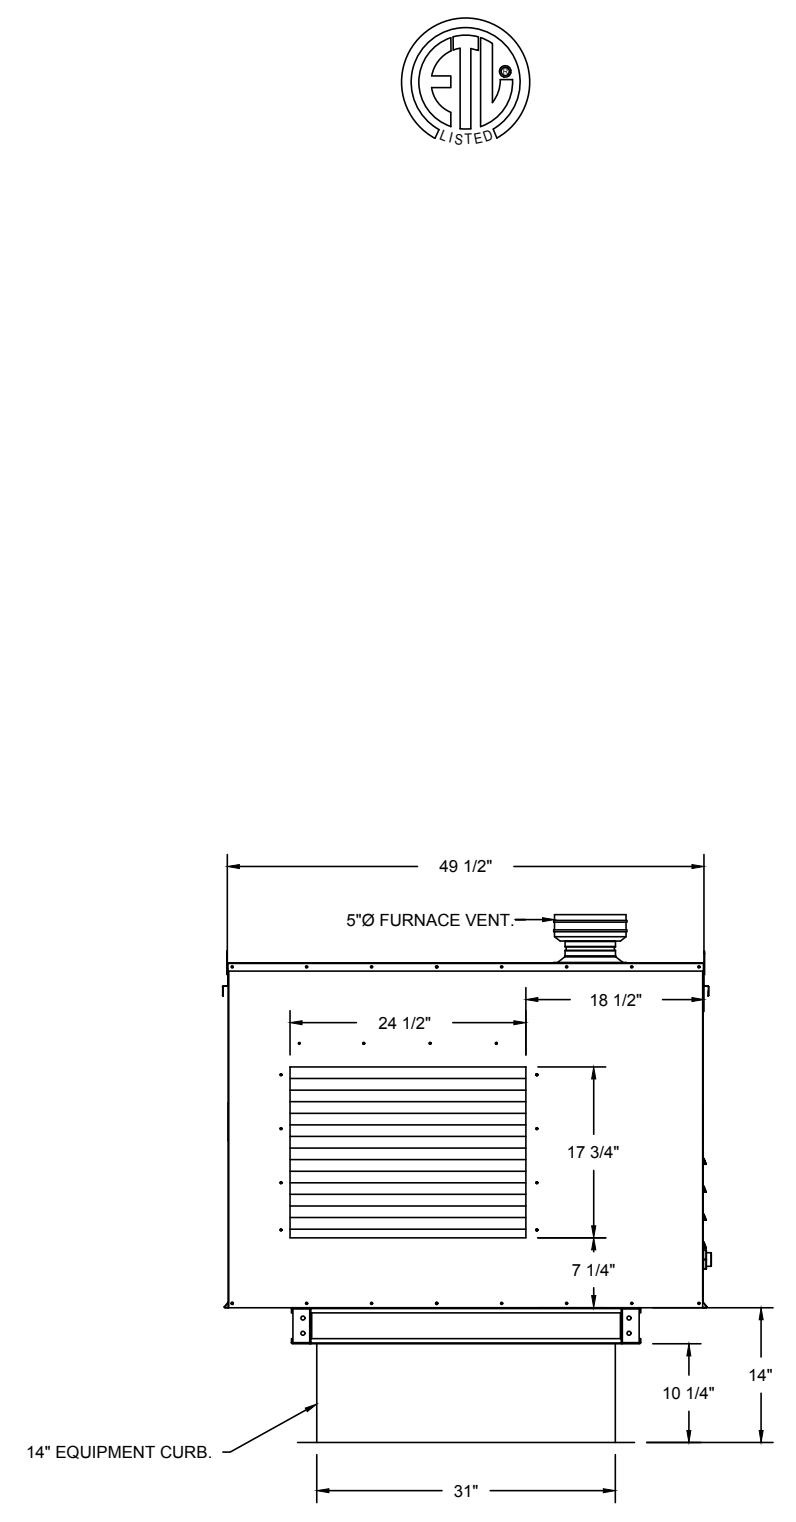

These products and others are available for demonstration at the Northern CA display center
 information or questions Contact:
 Captive Aire Systems
 1110 Burnett Ave, Suite G, Concord, CA 94520
 Phone: (925)962-1999, Fax: (925)966-8565
 Email: rep@2@captiveaire.com

REVISIONS

NO.	REVISION DESCRIPTION	DATE
1	ADDENDUM 2	2023/03/20

CAPTIVE
 Northern California Office
 www.captiveaire.com
 1110 Burnett Ave, Suite G, Concord, CA 94520 PHONE: (925) 962-1999 FAX: (925) 966-8565 EMAIL: rep@2@captiveaire.com

Woodland Culinary Classroom
 575 Hays Street,
 Woodland, CA, 95695

DATE: 3/9/2023
 DWG.#: 5668675
 DRAWN BY:
 SCALE: 3/4" = 1'-0"
 MASTER DRAWING

SHEET NO. 4

APPROVALS

PO Box 1900
 Yuba City, CA 95992-1900
 530.298.7298
 www.spinc-arch.com

SYNTHESIS PARTNERS, LLC
 Managers • Architects

WESTON & ASSOCIATES
 MECHANICAL ENGINEERS
 601 UNIVERSITY AVE., SUITE 260 | SACRAMENTO, CA 95825
 WESTON & ASSOCIATES #22-033

OWNER
 Woodland Joint Unified School District
 435 6th Street
 Woodland, CA 95695

PROJECT
 CLASSROOM CONVERSIONS
 at
 WOODLAND EDUCATION CENTER
 575 Hays Street
 Woodland, CA 95695

KEY PLAN


FOR PEAN REVIEW ONLY
 NOT FOR CONSTRUCTION

NO.	REVISION DESCRIPTION	DATE
1	ADDENDUM 2	2023/03/20

MECHANICAL SCHEDULES & NOTES



DATE 2022-07-24
 PROJECT NO. 21-W04-01

M0.5

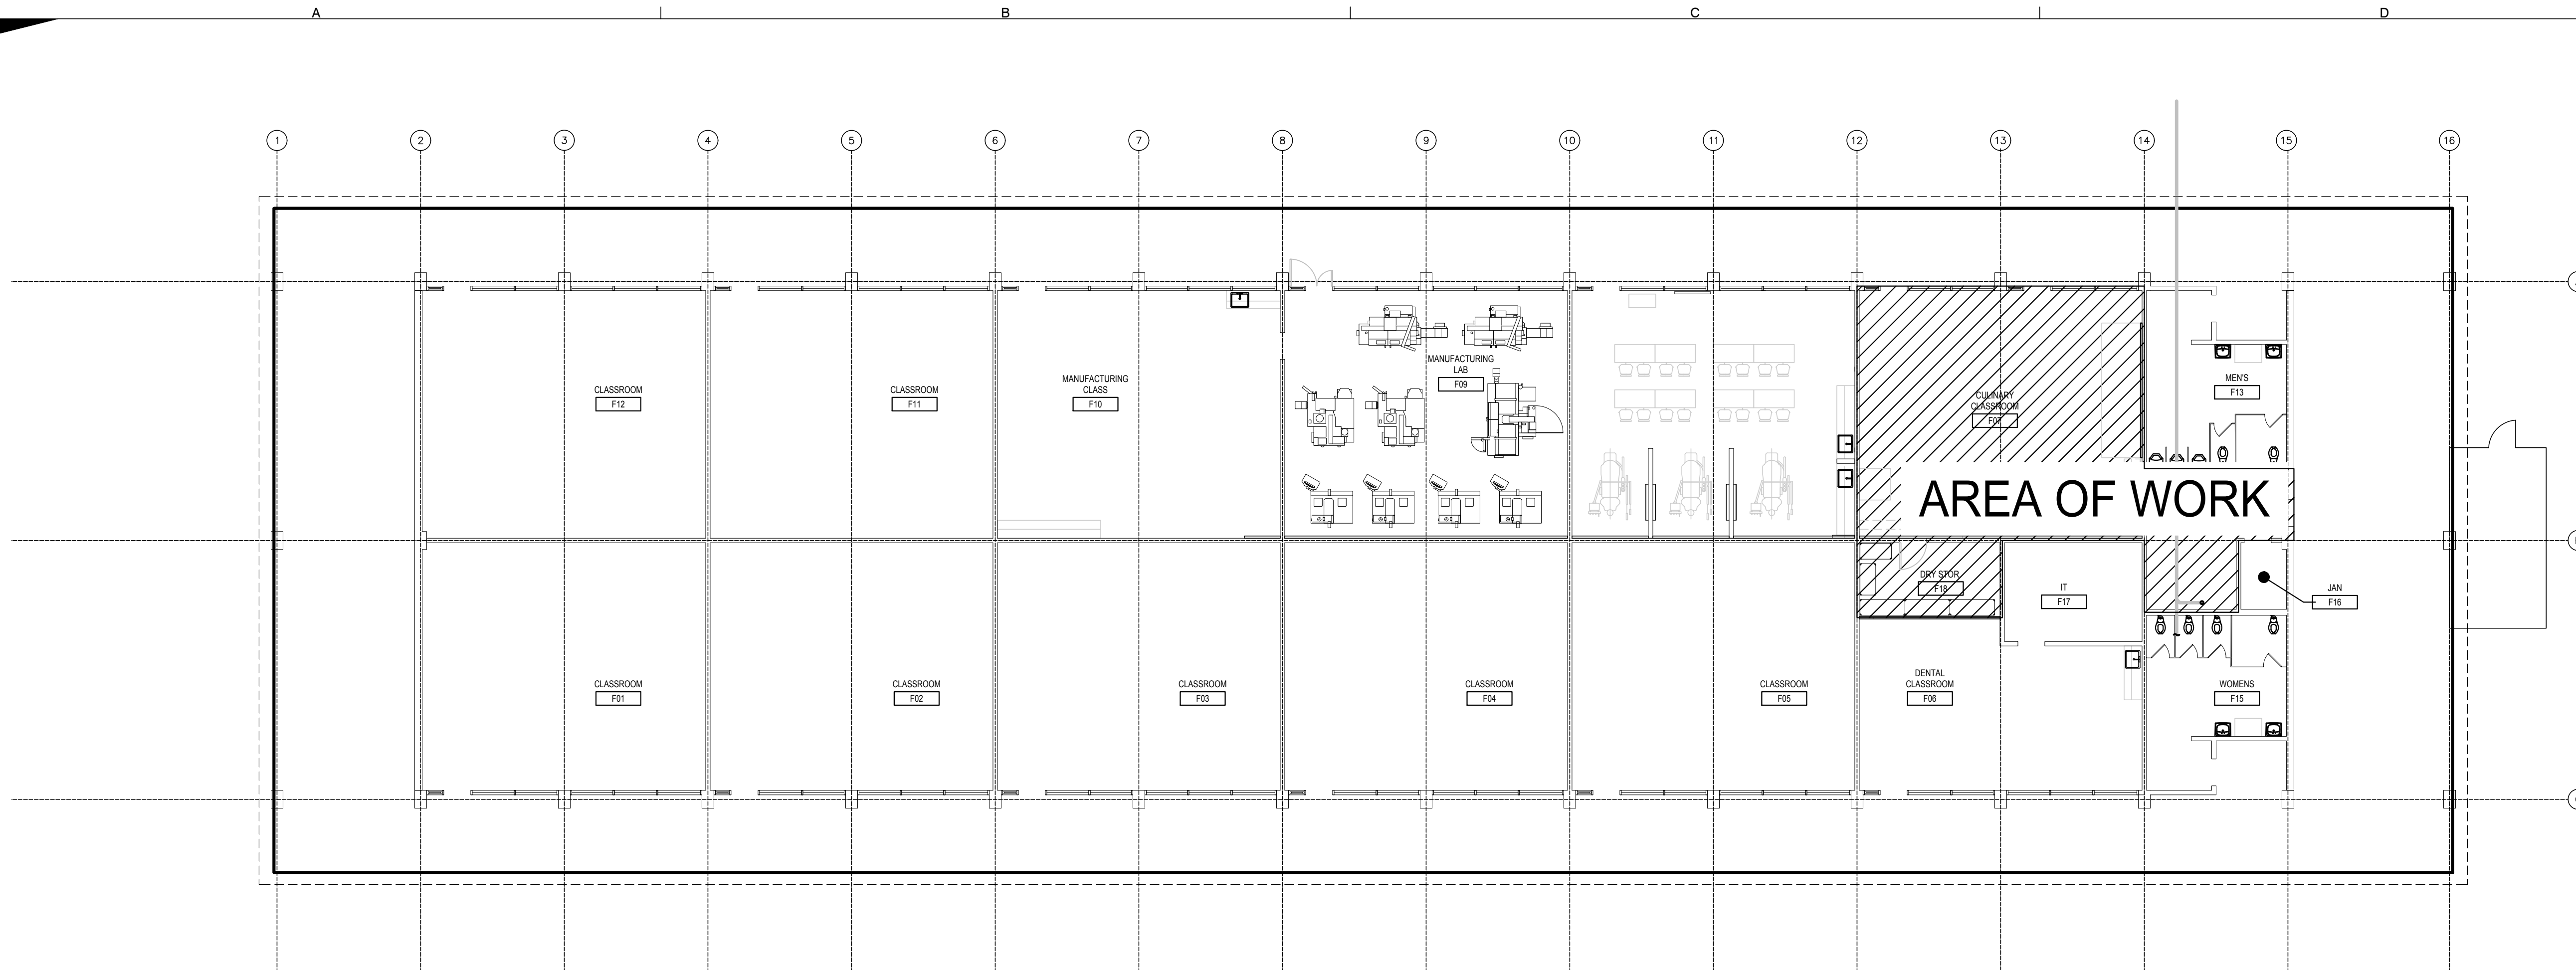



OVERALL MECHANICAL FLOOR PLAN

SCALE: 3/32" = 1'-0"

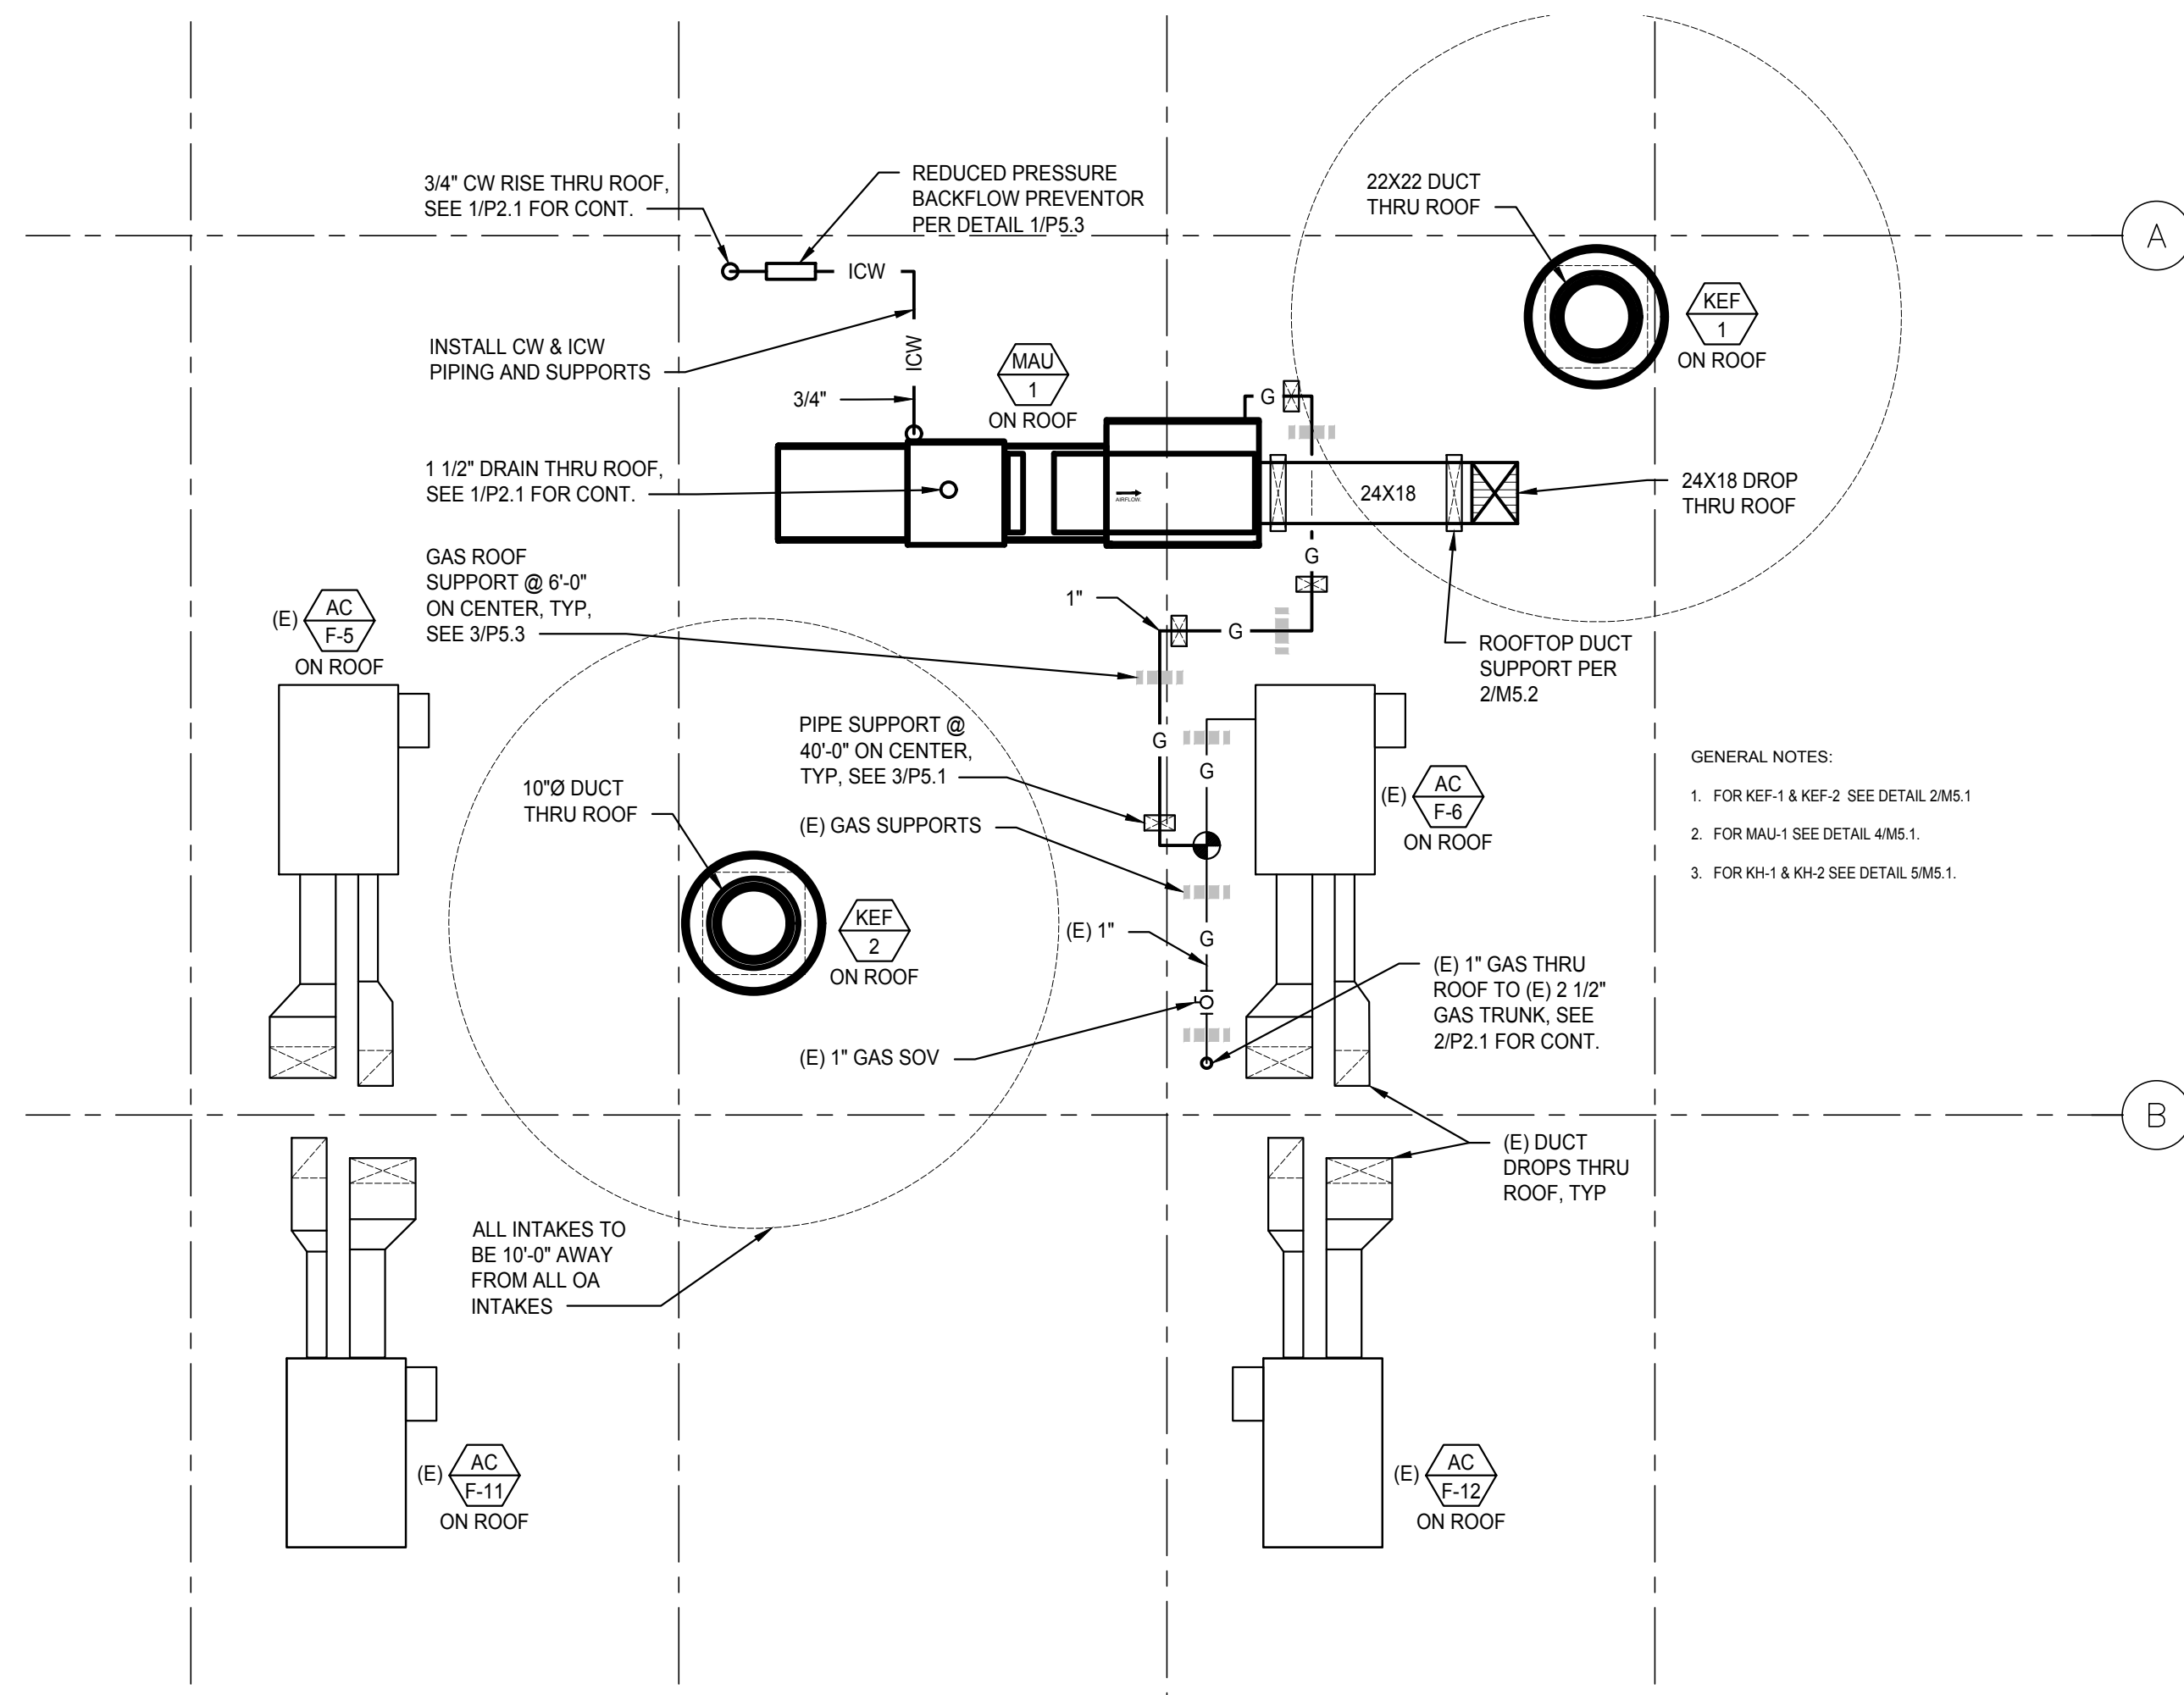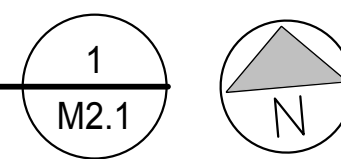


PARTIAL MECHANICAL ROOF PLAN

SCALE: 3/16" = 1'-0"

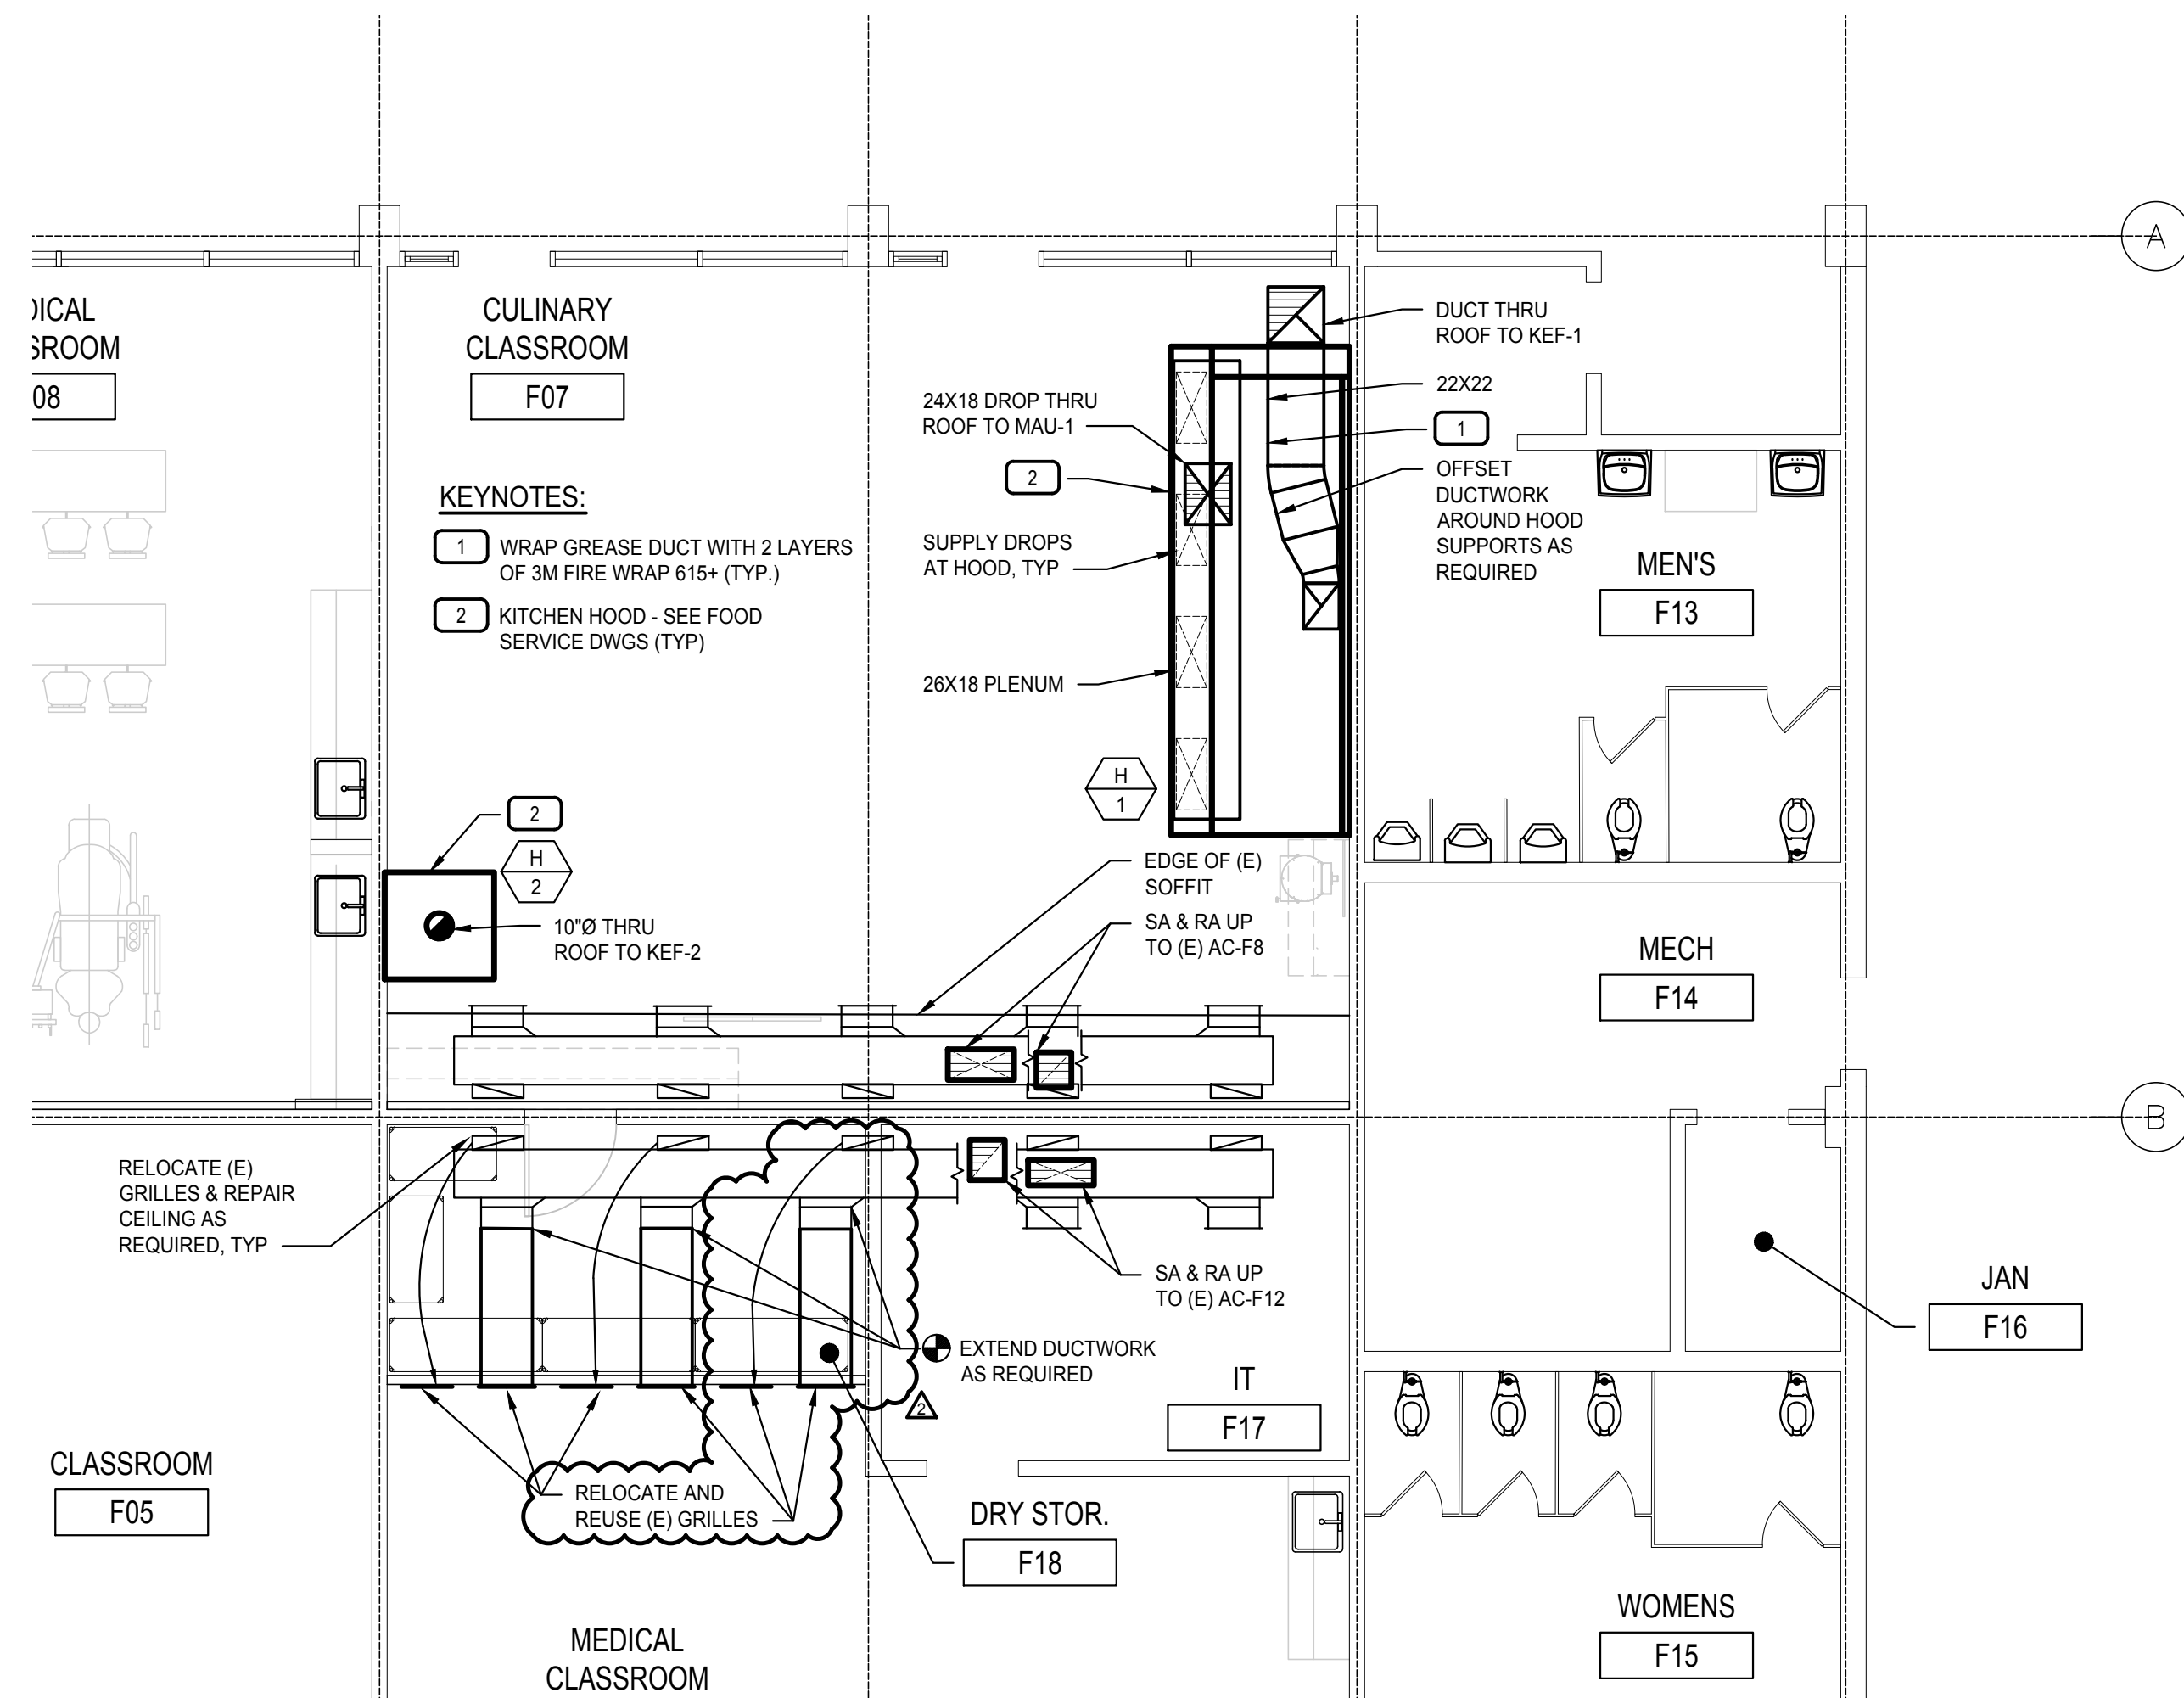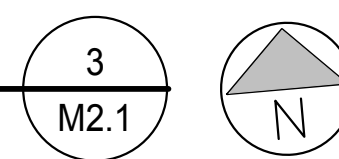

PARTIAL MECHANICAL FLOOR PLAN

SCALE: 3/16" = 1'-0"

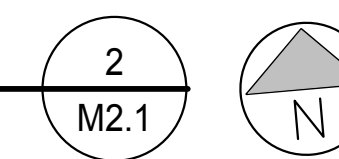

©2023 Synthesis Partners, LLC All Rights Reserved
 These record drawings have been prepared based upon information submitted, in part, by others. While this information is believed to be reliable, the Architect is not responsible for any errors or omissions which may appear hereon or which may be caused by the use of these documents as a result.

APPROVALS

PO Box 1900
 Yuba City, CA 95992-1900
 530.298.7298
 www.spinc-arch.com

ARCHITECTURAL • COMMERCIAL • RESIDENTIAL • INTERIOR • CONSTRUCTION MANAGEMENT



SYNTHESIS PARTNERS, LLC
 Managers • Architects

WESTON & ASSOCIATES
 MECHANICAL ENGINEERS
 601 UNIVERSITY AVE., SUITE 260 | SACRAMENTO, CA 95825
 WESTON & ASSOCIATES #22-033



OWNER

Woodland Joint Unified School District
 435 6th Street
 Woodland, CA 95695

PROJECT

CLASSROOM CONVERSIONS
 at
 WOODLAND EDUCATION CENTER
 575 Hays Street
 Woodland, CA 95695

KEY PLAN

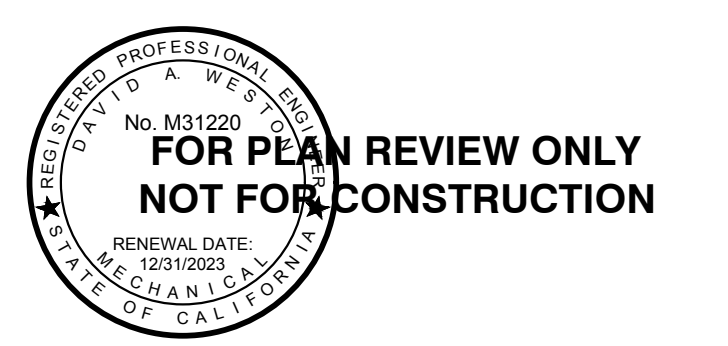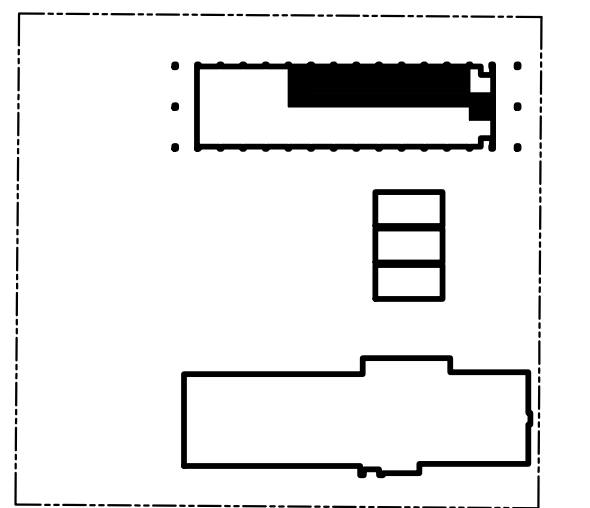

NO.	REVISION DESCRIPTION	DATE
ADDENDUM 2		2023/03/20

MECHANICAL OVERALL PLAN & PARTIAL PLANS

DATE: 2022-07-24
 PROJECT NO.: 21-W04-01

M2.1


3M™ Fire Barrier Duct Wrap 615+ Commercial Kitchen Grease Duct Systems (Figure 1)

1- or 2-Hour Shaft Alternative Zero Clearance to Combustibles
Telescoping Wrap Technique With Banding For Ducts 24" (60.9cm) or Less

1. First layer 3M™ Fire Barrier Duct Wrap 615+
2. Second layer 3M™ Fire Barrier Duct Wrap 615+
3. 3/4" (19mm) wide filament tape
4. Steel banding 1/2" (12.7mm) wide min. typical for permanent fastening
5. Longitudinal joint butt or min. 3" (76.2mm) overlap on inner layer, min. 3" (76.2mm) overlap on outer layer
6. Perimeter (lateral) joint butt or min. 3" overlap (76.2mm) on inner layer, min. 3" (76.2mm) overlap on outer layer
7. Metallic commercial cooking exhaust duct

Note: System integrity is limited by quality of installation. Ducts \geq 24" (60.9cm) wide require pinning on the bottom side of horizontal ducts and on a minimum of one of the wider sides of a vertical duct. Vertical ducts require pinning on all sides $>$ 48" (121.8cm).

Note: See manufacturer installation instructions for additional information.

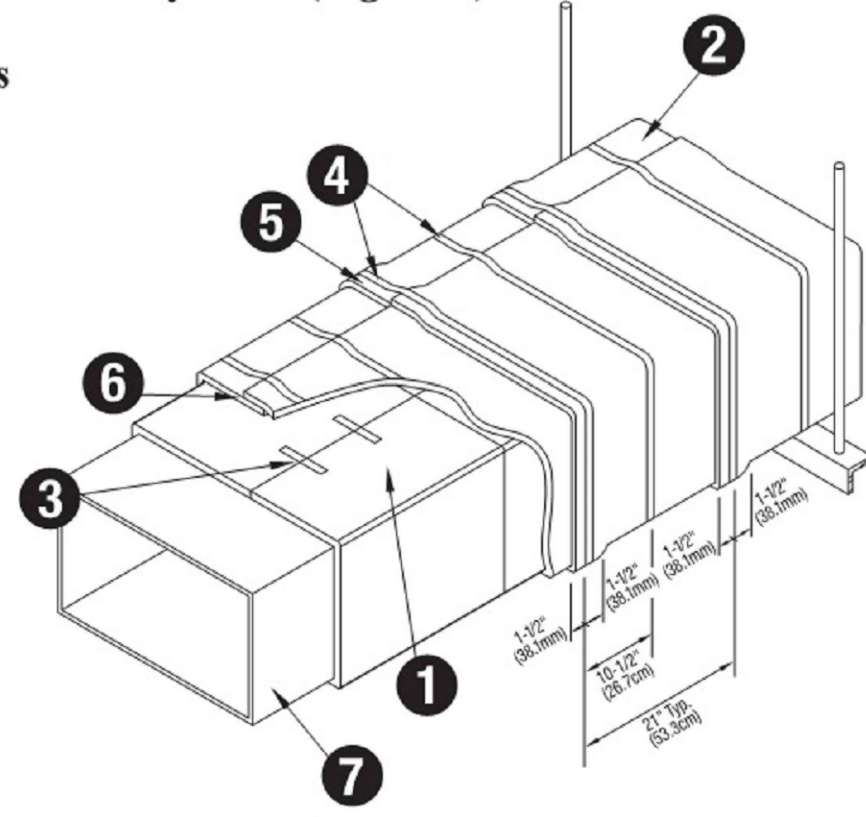


GENERAL NOTES:

1. 3M FIRE BARRIER DUCT WRAP 615+ CSFM 2440-0941.112.


3M FIRE WRAP DETAIL

NTS

5
M5.2

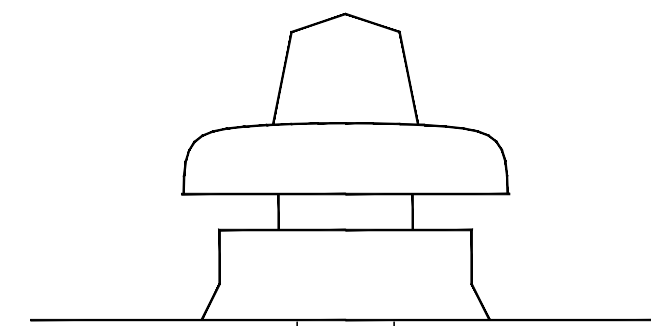

AC	EF
(E) AC-F6	KEF-2

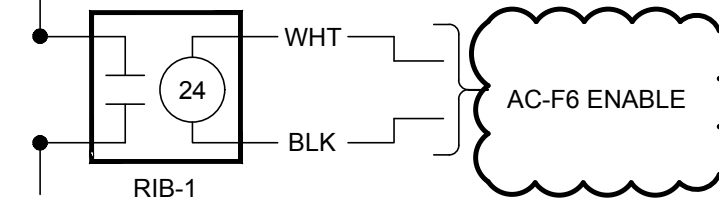

POWER BY E.C.

EXHAUST FAN INTERLOCKS
INTERLOCK SCHEDULE


GENERAL NOTES:

1. SEE PLANS AND SCHEDULES FOR QUANTITIES.
2. POWER BY DIVISION 23.
3. EF INTERLOCKED TO UNIT BY CONTROLS CONTRACTOR.
4. KEF-2 SHALL BE STARTED FROM HOOD SWITCH. KEF-2 SHALL BE INTERLOCKED TO (E) AC-F6.

EXHAUST FAN CONTROLS

NTS

4
M5.2

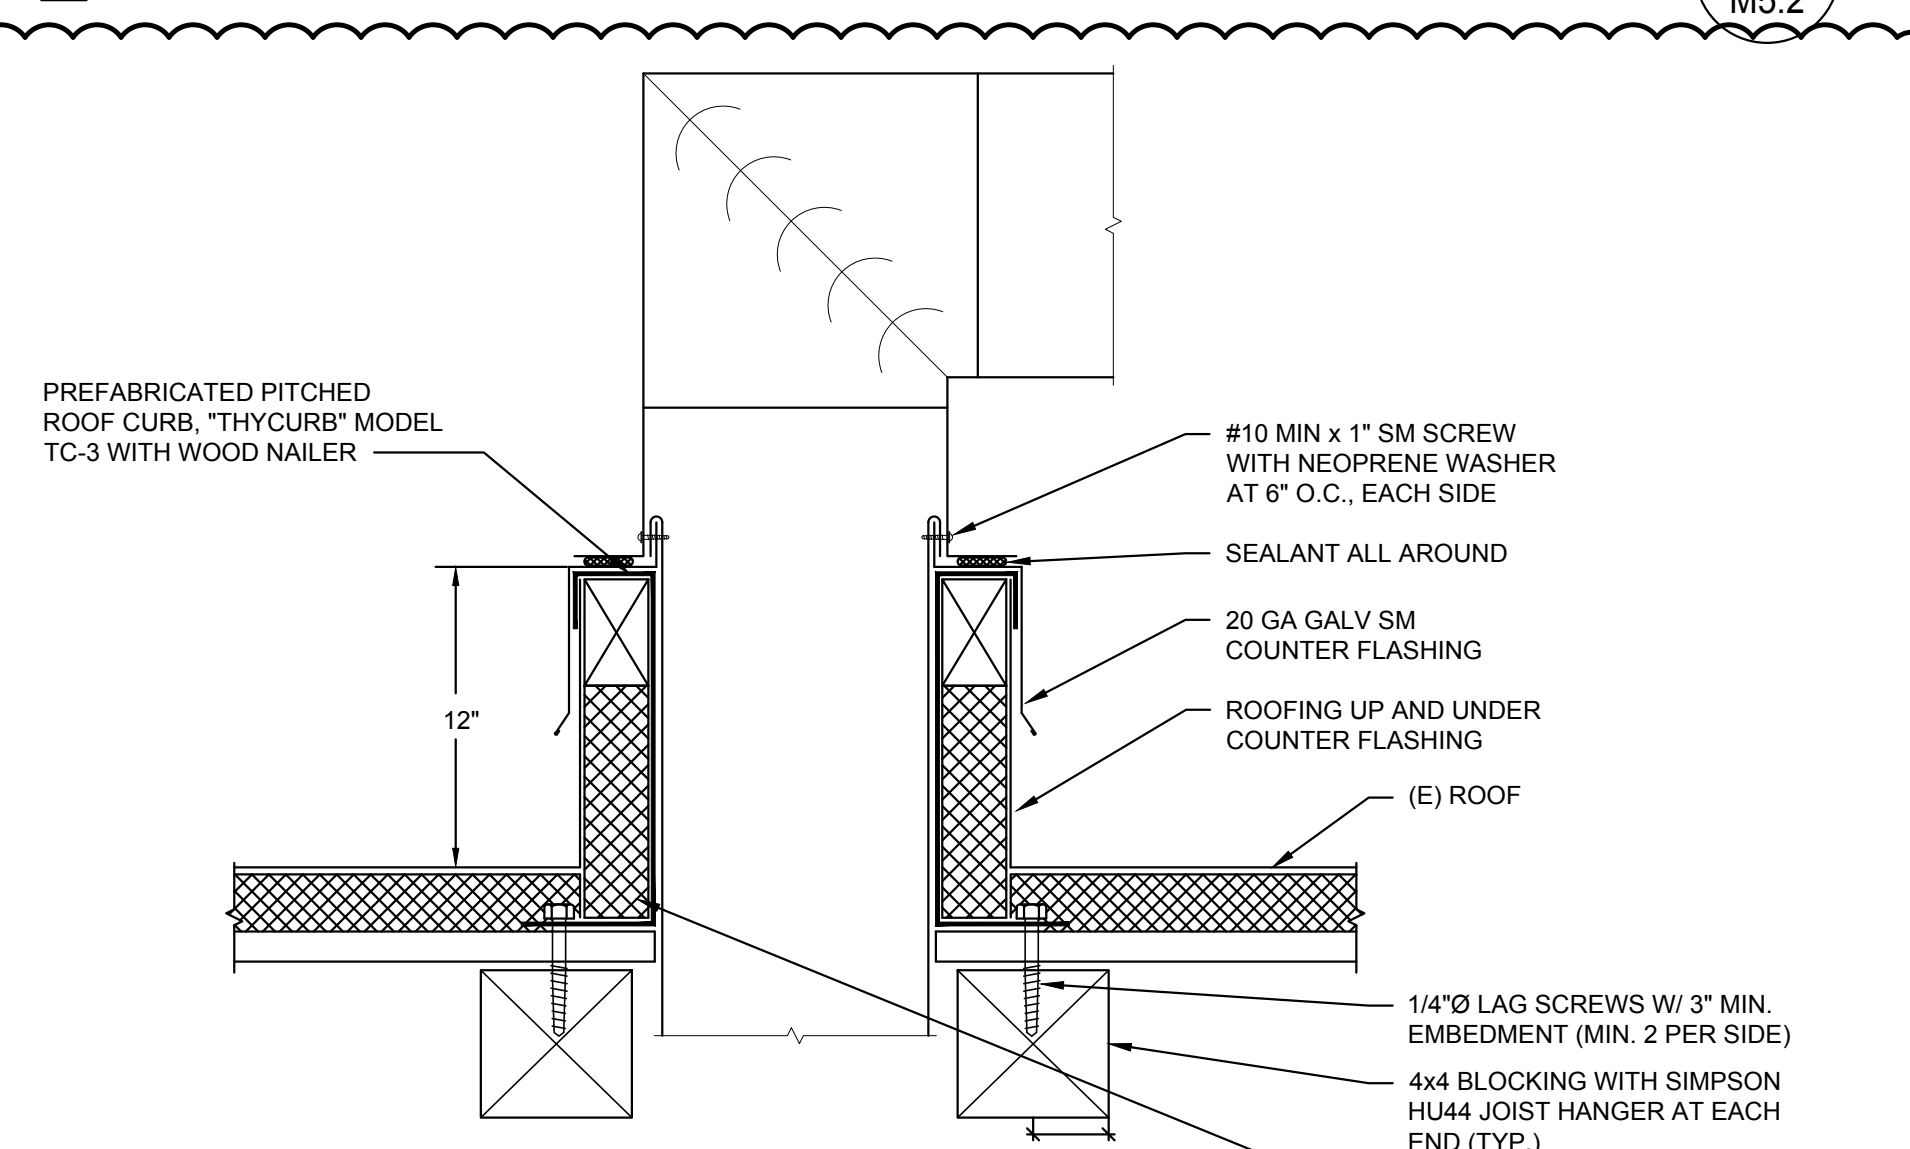


NOTE: IF REQUIRED, WOOD NAILERS TO BE FIRE TREATED WOOD WITH STAINLESS STEEL HARDWARE, SIMILAR TO DETAIL 4/M5.1.

DUCT THRU ROOF DETAIL


NTS

1" MIN EDGE DIST

3
M5.2

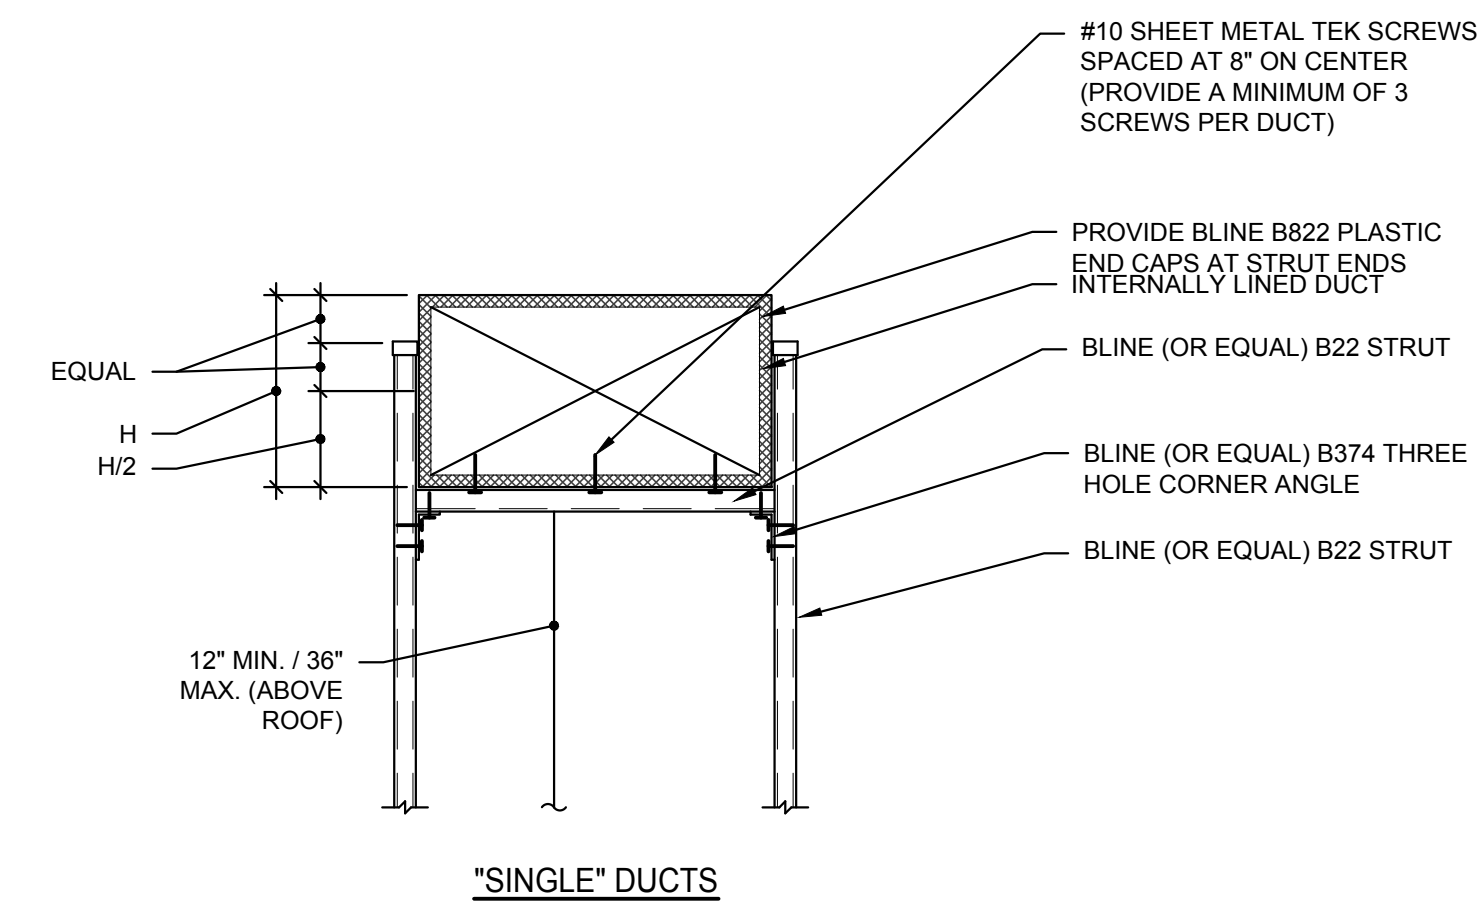

"SINGLE" DUCTS

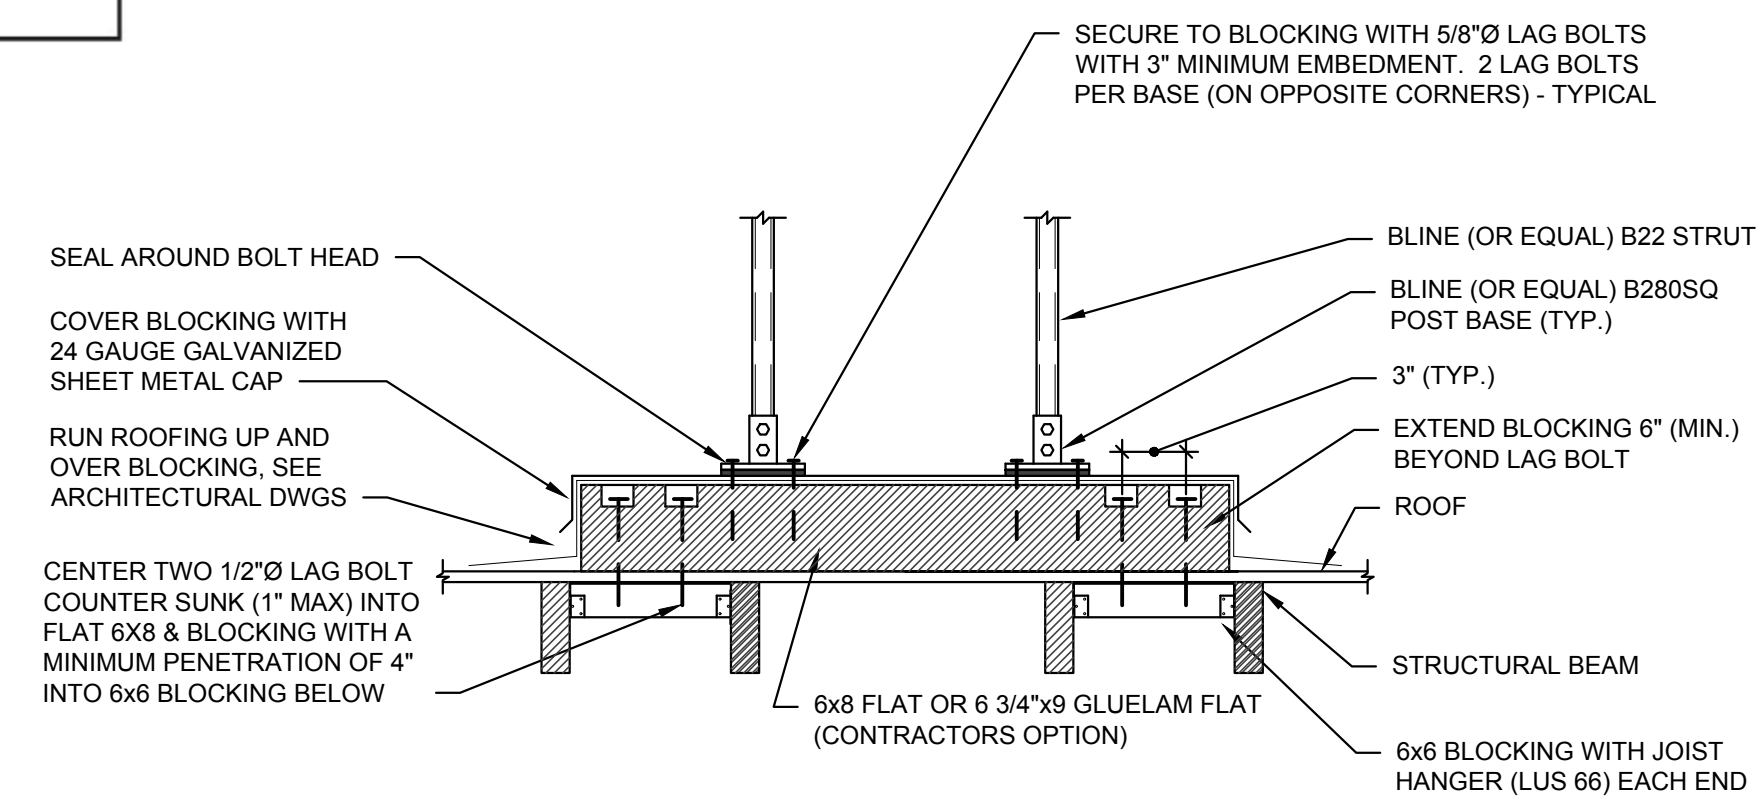


NOTES:

1. CONNECT STRUT/FITTINGS TOGETHER WITH MANUFACTURERS HEX SCREWS AND STANDARD NUTS (WITHOUT SPRINGS). PROVIDE LOCK WASHER AT EACH CONNECTION.
2. MAXIMUM SPACING BETWEEN SUPPORTS TO BE 6'-0".

DUCT SUPPORT ON WOOD DECK ROOF DETAIL

NTS

2
M5.2

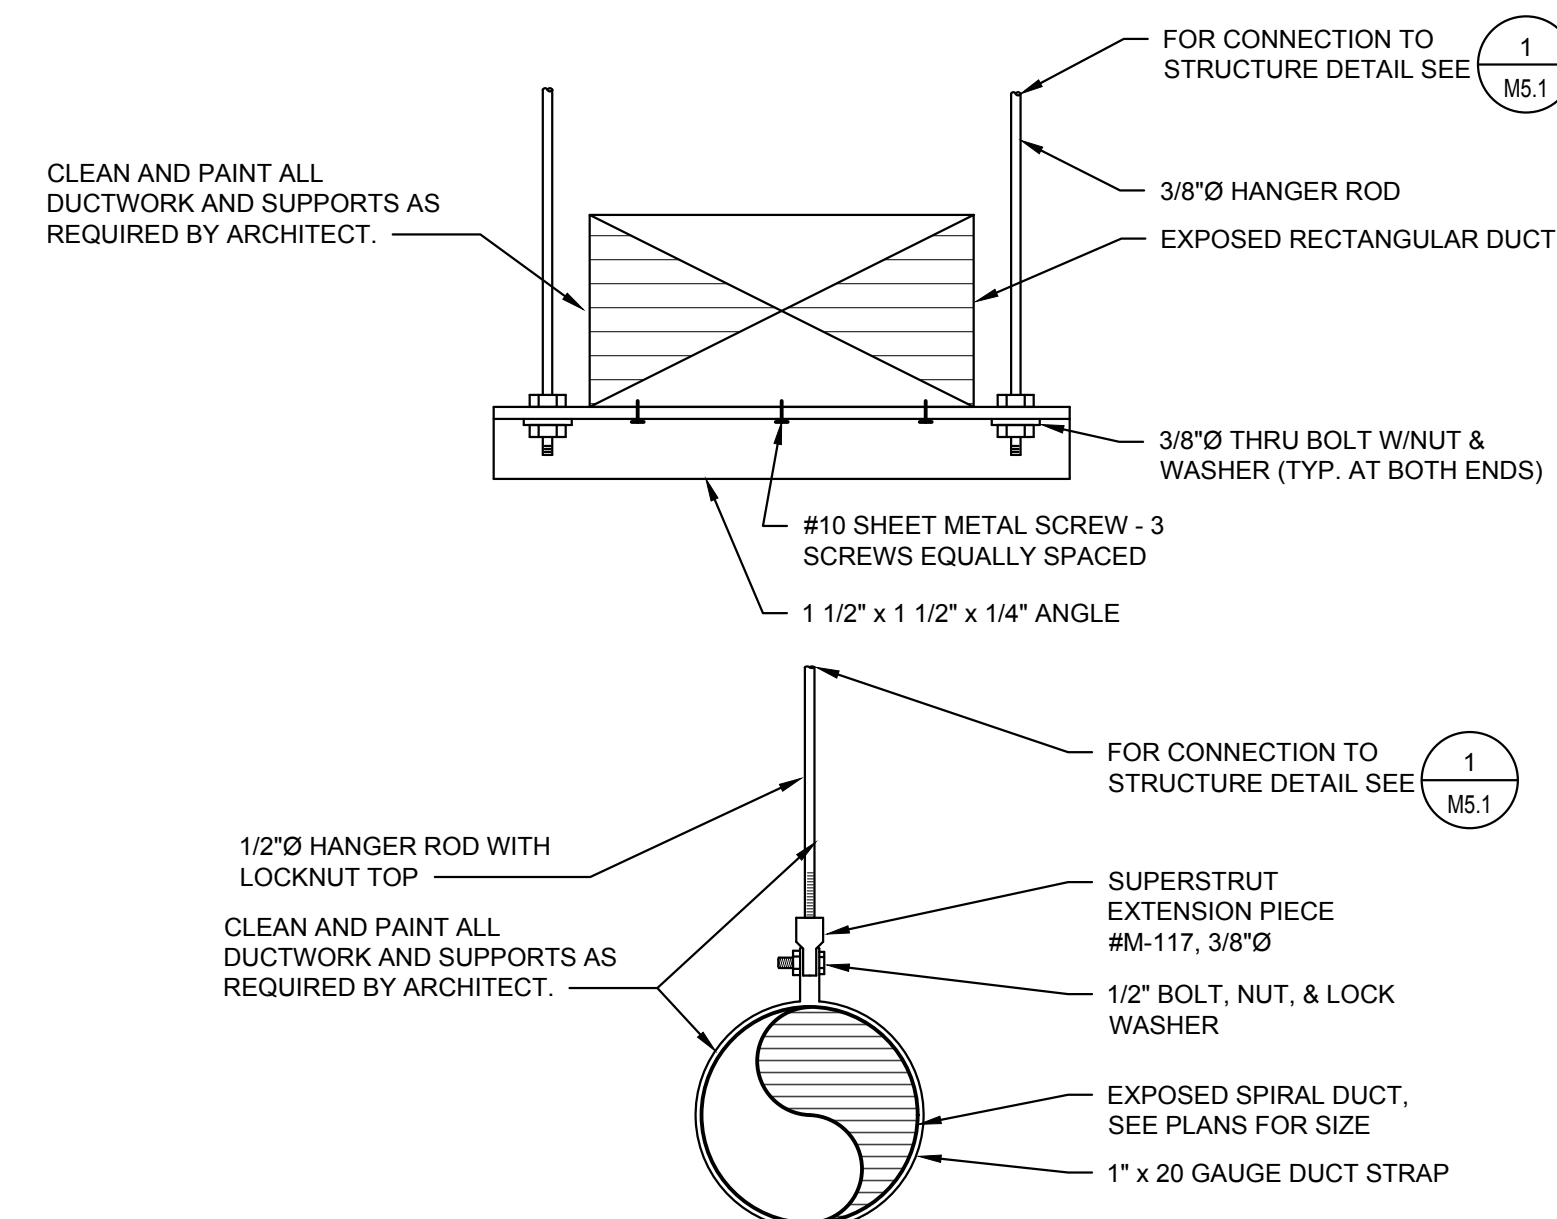

NOTES:

1. MAXIMUM SPACING OF SUPPORTS TO BE 10'-0".

EXPOSED DUCT MOUNTING DETAIL

SCALE: NONE

1
M5.2

©2023 Synthesis Partners, LLC All Rights Reserved
These record drawings have been prepared based upon information submitted, in part, by others. While this information is believed to be reliable, the Architect is not responsible for any errors or omissions which may have been incorporated into these documents as a result.

APPROVALS

PO Box 1900
Yuba City, CA 95992-1900
530.298.7298
www.spinc-arch.com

ARCHITECTURAL • COMMERCIAL • RESIDENTIAL • INTERIOR • CONSTRUCTION MANAGEMENT



SYNTHESIS PARTNERS, LLC
Managers • Architects

WESTON & ASSOCIATES
MECHANICAL ENGINEERS
601 UNIVERSITY AVE., SUITE 260 | SACRAMENTO, CA 95825
WESTON & ASSOCIATES #22-033


OWNER

Woodland Joint Unified School District
435 6th Street
Woodland, CA 95695

PROJECT

CLASSROOM CONVERSIONS
at
WOODLAND EDUCATION CENTER
575 Hays Street
Woodland, CA 95695

KEY PLAN

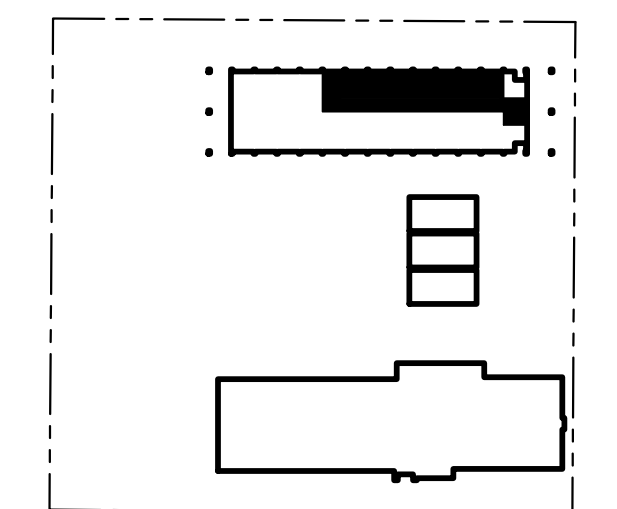

NO.	REVISION DESCRIPTION	DATE
Δ	ADDENDUM 2	2023/03/20

MECHANICAL DETAILS

M5.2

DATE 2022-07-24
PROJECT NO. 21-W04-01

ANCHORAGE / BRACING NOTES

ALL MECHANICAL AND PLUMBING COMPONENTS SHALL BE ANCHORED AND INSTALLED PER THE DETAILS ON THE DSA APPROVED CONTRACT DOCUMENTS. WHERE NO DETAIL IS INDICATED, THE FOLLOWING COMPONENTS SHALL BE ANCHORED OR BRACED TO MEET THE FORCE AND DISPLACEMENT REQUIREMENTS PRESCRIBED IN THE 2019 CBC, SECTION 1617A.1.18 THROUGH 1617A.1.26 AND ASCE 7-16, CHAPTERS 13, 26 AND 30:

- ALL PERMANENT EQUIPMENT AND COMPONENTS.
- TEMPORARY, MOVABLE OR MOBILE EQUIPMENT THAT IS PERMANENTLY ATTACHED (E.G. HARD WIRED) TO THE BUILDING UTILITY SERVICES SUCH AS ELECTRICITY, GAS, OR WATER, "PERMANENTLY ATTACHED" SHALL INCLUDE ALL ELECTRICAL CONNECTION EXCEPT PLUGS FOR 110/220 VOLT RECEPTACLES HAVING A FLEXIBLE CABLE.
- TEMPORARY, MOVABLE OR MOBILE EQUIPMENT WHICH IS HEAVIER THAN 400 POUNDS OR HAS A CENTER OF MASS LOCATED 4 FEET OR MORE ABOVE THE ADJACENT FLOOR OR ROOF LEVEL THAT DIRECTLY SUPPORT THE COMPONENT IS REQUIRED TO BE RESTRAINED IN A MANNER APPROVED BY DSA.
- MOVABLE EQUIPMENT WHICH IS STATIONED IN ONE PLACE FOR MORE THAN 8 HOURS AND HEAVIER THAN 400 POUNDS OR HAS A CENTER MASS LOCATED 4 FEET OR MORE ABOVE THE ADJACENT FLOOR OR ROOF LEVEL THAT DIRECTLY SUPPORT THE COMPONENT ARE REQUIRED TO BE ANCHORED WITH TEMPORARY ATTACHMENTS.

THE FOLLOWING MECHANICAL COMPONENTS SHALL BE POSITIVELY ATTACHED TO THE STRUCTURE BUT NEED NOT DEMONSTRATE DESIGN COMPLIANCE WITH THE REFERENCES NOTED ABOVE. THESE COMPONENTS SHALL HAVE FLEXIBLE CONNECTIONS PROVIDED BETWEEN THE COMPONENT AND ASSOCIATED DUCTWORK AND PIPING. FLEXIBLE CONNECTION MUST ALLOW MOVEMENT IN BOTH TRANSVERSE AND LONGITUDINAL DIRECTIONS.

- COMPONENTS WEIGHING LESS THAN 400 POUNDS AND HAVING A CENTER OF MASS LOCATED 4 FEET OR LESS ABOVE THE ADJACENT FLOOR OR ROOF LEVEL THAT DIRECTLY SUPPORT THE COMPONENT.
- COMPONENTS WEIGHING LESS THAN 20 POUNDS, OR IN THE CASE OF DISTRIBUTED SYSTEMS, LESS THAN 5 POUNDS PER FOOT, WHICH ARE SUSPENDED FROM A ROOF OR FLOOR OR HUNG FROM A WALL.

THE ANCHORAGE OF ALL MECHANICAL AND PLUMBING COMPONENTS SHALL BE SUBJECT TO THE APPROVAL OF THE DESIGN PROFESSIONAL IN GENERAL RESPONSIBLE CHARGE OR STRUCTURAL ENGINEER DELEGATED RESPONSIBILITY AND ACCEPTANCE BY DSA. THE PROJECT INSPECTOR WILL VERIFY THAT ALL COMPONENTS AND EQUIPMENT HAVE BEEN ANCHORED IN ACCORDANCE WITH THE ABOVE REQUIREMENTS.

PIPING AND DUCTWORK SYSTEM BRACING NOTE:

PIPING AND DUCTWORK SHALL BE BRACED TO COMPLY WITH THE FORCE AND DISPLACEMENTS PRESCRIBED IN ASCE 7-16 SECTION 13.3 AS DEFINED IN ASCE 7-16 SECTION 13.6.5, 13.6.6, 13.6.7, 13.6.8, AND 2019 CBC, SECTIONS 1617A.1.24, 1617A.1.25, AND 1617A.1.26.

THE METHOD OF SHOWING BRACING AND ATTACHMENT TO THE STRUCTURE FOR THE IDENTIFIED DISTRIBUTION SYSTEM ARE AS NOTED BELOW. WHEN BRACING AND ATTACHMENTS ARE BASED ON A PRE APPROVED INSTALLATION GUIDE (E.G. SMACNA OR OSHPD OPM#), COPIES OF THE BRACING SYSTEM INSTALLATION GUIDE OR MANUAL SHALL BE AVAILABLE ON THE JOBSITE PRIOR TO THE START OF AND DURING THE HANGING AND BRACING OF THE DISTRIBUTION SYSTEMS. THE STRUCTURAL ENGINEER OF RECORD SHALL VERIFY THE ADEQUACY OF THE STRUCTURE TO SUPPORT THE HANGER AND BRACE LOADS.

PLUMBING PIPING (PP)

PP - OPTION 1:

DETAILED ON THE APPROVED DRAWINGS WITH PROJECT SPECIFIC NOTED AND DETAILS.

X PP -

OPTION 2:

SHALL COMPLY WITH THE APPLICABLE OSHPD PRE-APPROVAL (OPM#), MASON OPM-0043-13 SEISMIC RESTRAINT SYSTEMS GUIDELINE.

PLUMBING GENERAL NOTES

- MECHANICAL AND PLUMBING DETAILS APPLY TO ALL BUILDINGS WHETHER REFERENCED OR NOT.
- PROVIDE FIRE STOPPING ASSEMBLY PROTECTION FOR PIPE PENETRATIONS OF RATED ASSEMBLIES. FIRE STOP RATING SHALL MATCH RATED ASSEMBLY BEING PENETRATED.
- PLUMBING AND FIRE SPRINKLER PIPING SHALL OFFSET OVER OR UNDER DUCTS. COORDINATE WITH HEATING CONTRACTOR.
- PLUMBING CONTRACTOR TO OFFSET PIPING AROUND SKYLIGHTS.
- PLUMBING CONTRACTOR TO OFFSET PIPING AROUND ROOF ACCESS LADDERS.
- PIPING SHALL NOT PENETRATE INTO, OVER, OR THROUGH IT CLOSETS OR ELECTRICAL ROOMS UNLESS IT SERVES THAT SPECIFIC ROOM.
- DRAWINGS SHALL BE CONSIDERED DIAGRAMMATIC IN NATURE AND ARE NOT INTENDED TO SHOW EVERY OFFSET, FITTING, OR STRUCTURAL DIFFICULTY THAT MAY BE ENCOUNTERED DURING INSTALLATION OF WORK. THE CONTRACTORS SHALL COORDINATE LOCATION OF ALL PLUMBING PIPING WITH ALL OTHER TRADES ON THIS PROJECT. LOCATION OF ALL ITEMS NOT DEFINITELY FIXED BY DIMENSIONS ARE APPROXIMATE ONLY. EXACT LOCATIONS NECESSARY TO SECURE BEST CONDITIONS AND RESULTS MUST BE DETERMINED AT THE JOB SITE AND SHALL HAVE THE APPROVAL OF THE ARCHITECT BEFORE BEING INSTALLED.
- ALL VALVES SHALL BE FULL LINE SIZES UNLESS NOTED OTHERWISE.
- PROVIDE WALL CLEANOUT AT ALL SINKS, LAVATORIES, AND URINALS.
- PIPING SHALL BE SUPPORTED IN ACCORDANCE TO SMACNA "GUIDELINES FOR SEISMIC RESTRAINTS OF MECHANICAL AND PLUMBING PIPING SYSTEMS".
- ALL NEW SANITARY WASTE PIPING SHALL HAVE A MINIMUM BURRY DEPTH OF 18" AND BE SLOPED AT 1/4" PER FOOT MINIMUM UNLESS OTHERWISE NOTED. PIPING SHALL BE UNIFORMLY SLOPPED BETWEEN UPPER TERMINAL OF PIPE AND THE POINT OF CONNECTION TO THE SITE PIPING (AS INDICATED ON CIVIL PLANS) TO ACHIEVE MAXIMUM SLOPE POSSIBLE.
- ACCESS PANELS SHALL BE PROVIDED AS NECESSARY TO PROPERLY ACCESS THE PLUMBING SYSTEM INCLUDING VALVES, EQUIPMENT, HOPPER DRAINS, AND INDIRECT DRAINS IN WALLS.
- HVAC EQUIPMENT IS SHOWN FOR THE COORDINATION OF UTILITIES ONLY. REFER TO "M" SHEETS FOR ADDITIONAL INFORMATION.
- PROVIDE WATER HAMMER ARRESTORS (WHA) AT ALL FIXTURES AS INDICATED IN THE SPECIFICATIONS/NOTES. WHA SHALL BE SIZED AND PER THE PLUMBING & DRAINAGE INSTITUTE (PDI). WHA SHALL BE INSTALLED IN WALLS (NOT ABOVE CEILINGS).
- REFERENCE ARCHITECTURAL DRAWINGS FOR BUILDING DIMENSIONS, EXACT LOCATIONS OF PLUMBING FIXTURES, AND PLUMBING FIXTURE MOUNTING HEIGHTS.
- CONCEAL ALL PIPING IN WALL FURRINGS, PARTITIONS, ABOVE CEILINGS, EXCEPT IN MECHANICAL ROOMS OR WHERE NOTED OTHERWISE.
- PROVIDE A TRAP PRIMER AT ALL FLOOR DRAINS AND FLOOR SINKS.

APPLICABLE CODES

ALL WORK PERFORMED UNDER THIS CONTRACT IS TO CONFIRM TO THE FOLLOWING CODES AND REGULATIONS:

- CALIFORNIA ADMINISTRATIVE CODE, 2022
- CALIFORNIA BUILDING CODE, 2019
- CALIFORNIA MECHANICAL CODE, 2019
- CALIFORNIA PLUMBING CODE, 2019
- CALIFORNIA FIRE CODE, 2019
- CALIFORNIA ELECTRICAL CODE, 2019
- CALIFORNIA BUILDING ENERGY EFFICIENCY STANDARDS, 2019

THE ABOVE CODES AND REGULATIONS REFER TO THE LATEST EDITION OR REVISION IF FORCE ON THE DATE OF THE CONTRACT, UNLESS OTHERWISE STATED. NOTHING ON THE DRAWINGS IS TO BE CONSTRUED AS REQUIRING OR PERMITTING WORK THAT IS CONTRARY TO THE LISTED CODES AND REGULATIONS, OR OTHER LOCAL, STATE OR FEDERAL CODES OR REGULATIONS WHICH MAY BE APPLICABLE.

GAS PIPE SIZING

GAS LOAD (EACH) (MBH)	QUANTITY	TOTAL GAS LOAD (MBH)	DESCRIPTION
60	12	720	(E) AC-UNITS
190	1	190	MAU-1
76	1	76	GWH-1
OVERALL GAS DEMAND		986	
GAS MAIN SIZING AT 175' TOTAL DEVELOPED LENGTH			
GAS DEMAND (MBH)	PIPE SIZE	NOTES:	
63	3/4"	1. SEE FLOOR PLAN FOR EQUIPMENT LOCATIONS.	
119	1"		
244	1-1/4"		
366	1-1/2"		
704	2"		
1,120	2 1/2"		
1,980	3"		

GAS PIPE SIZING BASED ON TABLE 1215.2(1) CPC-2019 (PRESSURE DROP OF 1 PSI), 250 FOOT COLUMN. GPR OUTLET PRESSURE AT 7" WC. RUNOUTS TO APPLIANCES LESS THAN 6" SHALL BE SAME SIZE AS APPLIANCE CONNECTION. PROVIDE A SHUT-OFF VALVE AHEAD OF UNION AND WITHIN 3'-0" OF APPLIANCE CONNECTOR.

PLUMBING LEGEND

ABBREVIATIONS

ABC	ABOVE CEILING	FT	FEET	POD	POINT OF DISCONNECT
AD	ACCESS DOOR	FU	FIXTURE UNITS	PRV	PRESSURE REDUCING VALVE
AFB	ABOVE FINISHED FLOOR	G	NATURAL GAS	PS	PRESSURE SWITCH
AFG	ABOVE FINISHED GRADE	GOO	GRADE CLEAN OUT	PSI	POUNDS PER SQUARE INCH
AP	ACCESS PANEL	GD	GARBAGE DISPOSER	PSIG	POUNDS PER SQUARE INCH GAUGE
AQ	AQUASTAT	GLV	GLOBE VALVE	PT	PLUGGED TEE
ARCH	ARCHITECT	GM	GAS METER	R	RISE / RISER
AV	ACID VENT	GPH	GALLONS PER HOUR	RD	ROOF DRAIN
AVTR	ACID VENT THRU ROOF	GPM	GALLONS PER MINUTE	RET	RETURN
AW	ACID WASTE	GPR	GAS PRESSURE REGULATOR	RIO	ROUGH IN ONLY
BFF	BELOW FINISHED FLOOR	GPRV	GAS PRESSURE REGULATOR VALVE	RM	ROOM
BFP	BACKFLOW PREVENTER	GSCK	GAS COCK	RO	REVERSE OSMOSIS WATER
BFV	BUTTERFLY VALVE	GSV	GAS SEISMIC VALVE	RV	RELIEF VALVE
BG	BELOW GRADE	GV	GATE VALVE	RWL	RAINWATER LEADER
BLV	BALL VALVE	GW	GREASE WASTE PIPING	SCD	SECONDARY CONDENSATE DRAIN
CA	COMPRESSED AIR	HB	HOSE BIBB	SCH	SCHEDULE
CAP	CAPACITY	HD	HOPPER DRAIN	SCW	COLD SOFT WATER
CB	CATCH BASIN	HPG	HIGH PRESSURE NATURAL GAS	SD	STORM DRAIN
CBV	CALIBRATED BALANCE VALVE	HW	DOMESTIC HOT WATER	SH	SHOWER
CD	CONDENSATE DRAIN	HWR	DOMESTIC HOT WATER RETURN	SHT	SHEET
CFH	CUBIC FEET PER HOUR	ICW	INDUSTRIAL COLD WATER	SHW	HOT SOFT WATER
CI	CAST IRON	IHW	INDUSTRIAL HOT WATER	SHWR	HOT SOFT WATER RETURN
CKV	CHECK VALVE	IHWTR	INDUSTRIAL HOT WATER RETURN	SK	SINK
CL	CENTER LINE	ID	INSIDE DIAMETER	SMS	SHEET METAL SCREW
CLG	CEILING	IE	INVERT ELEVATION	SOV	SHUT OFF VALVE
CMP	CORRUGATED METAL PIPE	IW	INDIRECT WASTE	SS	STAINLESS STEEL
CO	CLEANOUT	LA	LABORATORY AIR	STD	STANDARD
CO2	CARBON DIOXIDE	LAV	LAVATORY	STR	STRAINER
COP	CAP ON END OF PIPE	LBS	POUNDS	TA	TO ABOVE
COTF	CLEANOUT TO FLOOR	LG	LABORATORY GAS	TB	TO BELOW
COTG	CLEANOUT TO GRADE	LP	LOW PRESSURE	TEMP.	TEMPERATURE
CP	CIRCULATING PUMP	LWT	LEAVING WATER TEMPERATURE	TH	THERMOMETER
CR	CONCENTRIC REDUCER	MA	MEDICAL AIR	TMV	THERMOSTATIC MIXING VALVE
CSK	CLINIC SINK	MAX	MAXIMUM	TP	TRAP PRIMER
CV	CONTROL VALVE	MFR	MANUFACTURER	TYP	TYPICAL
CW	DOMESTIC COLD WATER	MGC	MEDICAL GAS COLUMN	TW	TEMPERED WATER
D	DROP	MIN	MINIMUM	UC	UNDER COUNTER
DCW	DOMESTIC COLD WATER	MISC	MISCELLANEOUS	UF	UNDER FLOOR
DD	DECK DRAIN	MPG	MEDIUM PRESSURE NATURAL GAS	UG	UNDERGROUND
DET	DETAIL	(N)	NEW	UN	UNION OR FLANGE
DF	DRINKING FOUNTAIN	N2	NITROGEN	UNO	UNLESS NOTED OTHERWISE
DHW	DOMESTIC HOT WATER	N2O	NITROUS OXIDE	UR	URINAL
DHWR	DOMESTIC HOT WATER RETURN	NC	NORMALLY CLOSED	V	SANITARY VENT
DI	DEIONIZED WATER	NIC	NOT IN CONTRACT	VB	VALVE BOX
DN	DOWN	NO	NORMALLY OPEN	VAC	MEDICAL VACUUM
DWG	DRAWING	NTS	NOT TO SCALE	VR	VENT RISER
(E)	EXISTING	O2	OXYGEN	VTR	VENT THRU ROOF
EWH	ELECTRIC WATER HEATER	OC	ON CENTER	W	SANITARY WASTE
EWT	ENTERING WATER TEMPERATURE	OFCI	OWNWER FURNISHED CONTRACTOR INSTALLED	WD	WASTE DROP
FA	FROM ABOVE	ORD	OVERFLOW ROOF DRAIN	WI	WITH
FB	FROM BELOW	ORWL	OVERFLOW RAIN WATER LEADER	WIO	WITHOUT
FC	FLEXIBLE CONNECTION	OH	OVERHEAD	WAGD	WASTE ANESTHESIA GAS DISPOSAL
FCO	FLOOR CLEAN OUT	P&TRV	PRESSURE & TEMPERATURE RELIEF VALVE PIPING	WC	WATER CLOSET
FD	FLOOR DRAIN	PL	PROPERTY LINE	WCO	WALL CLEAN OUT
FHC	FIRE HOSE RACK & CABINET	PAN	PIPE ANCHOR	WD	WASTE DROP
FLR	FLOOR	PG	PRESSURE GAUGE	WH	WALL HYDRANT
FPM	FEET PER MINUTE	PL	PLATE	WHA	WATER HAMMER ARRESTER
FSH	FIRE SPRINKLER HEAD	PLBG	PLUMBING	WM	WATER METER
FS	FLOOR SINK	POC	POINT OF CONNECTION	WSP	WET STANDPIPE
FSP	FIRE SPRINKLER PIPE				

SYMBOLS

	DOMESTIC COLD WATER LINE		ITEM TO BE REMOVED / DEMOED
	DOMESTIC HOT WATER		ITEM TO BE ABANDONED IN PLACE
	DOMESTIC HOT WATER HEAT TRACE		BALL VALVE
	DOMESTIC HOT WATER RETURN		BALANCE VALVE
	TEMPERED WATER		BUTTERFLY VALVE
	NON POTABLE WATER		CHECK VALVE
	INDUSTRIAL COLD WATER LINE		LEVER HANDLE GAS COCK
	INDUSTRIAL HOT WATER		PRESSURE REDUCING VALVE
	INDUSTRIAL HOT WATER RETURN		SOLENOID VALVE W/ MOTOR ACTUATOR
	SOIL OR WASTE LINE BELOW GRADE		STRAINER
	SOIL OR WASTE LINE ABOVE GRADE		PRESSURE GAUGE
	INDIRECT WASTE LINE		THERMOMETER
	GREASE WASTE LINE		UNION
	ACID WASTE LINE		TEMP. & PRESSURE RELIEF LINE
	VENT LINE		VALVE BOX
	ACID VENT LINE		CAP (END OF PIPE)
	RAINWATER LEADER LINE		CIRCULATING PUMP
	OVERFLOW RAINWATER LEADER LINE		ANGLE VALVE
	CONDENSATE DRAIN		PRESSURE OR TEMP. RELIEF VALVE
	NATURAL GAS LINE (LOW PRESSURE)		DIAMETER
	DENTAL VACUUM		CLEANOUT TO FLOOR
	DENTAL COMPRESSED AIR		CLEANOUT TO GRADE
	COMPRESSED AIR		CLEANOUT
	FLOW IN DIRECTION OF ARROW		FLOOR DRAIN
	REDUCER		FLOOR SINK
	RISER DOWN (ELBOW)		GAS TURRET
	RISER UP (ELBOW)		HOSE BIBB
	R, D RISE OR DROP		POINT OF CONNECTION
	GATE VALVE		POINT OF DISCONNECTION
	ROOM NAME		
	ROOM NAME AND NUMBER		

EQUIPMENT LIST

	<p>GAS WATER HEATER:</p> <p>*AO SMITH* CYCLONE HE MODULATING BURNER CONDENSING GAS FIRED WATER HEATER, MODEL BTX-80. HEATER SHALL BE RATED AT 76,000 BTUH INPUT AND PROVIDE 95 GPH RECOVERY AT 90°F TEMPERATURE RISE. TANK SHALL BE 50 GALLON CAPACITY AND BE CONSTRUCTED IN ACCORDANCE WITH ASME CODE.</p> <p>PROVIDE WITH MODEL BTX-80 CONCENTRIC VENT INTAKE/FLUE KIT, METAL EXHAUST ELBOW ASSEMBLY, AND MODEL BTX-80 CONDENSATE DRAIN NEUTRALIZATION KIT.</p> <p>120V/1Ø POWER</p> <p>SHIPPING WEIGHT = 225 LBS. / MAXIMUM OPERATING WEIGHT = 650 LBS.</p> <p>SET OUTLET TEMPERATURE TO 140°F.</p> <p>SEE DETAIL 1/P-5.1 FOR MOUNTING</p>
	<p>DOMESTIC WATER CIRCULATING PUMP:</p> <p>BELL AND GOSSET MODEL NBF-9U. PUMP TO BE AS FOLLOWS:</p> <ul style="list-style-type: none"> LEAD FREE BRONZE CIRCULATING PUMP 3/4" FLANGED CONNECTIONS PUMP TO BE CAPABLE OF PROVIDING 3 GPM AT 5 FEET HEAD 120V / 1Ø/60 HZ - 411W / 0.40 FLA PROVIDE WITH COMBINATION TC-1 AUTOMATIC TIMER KIT AND AQS-314" AQUASTAT. <p>OPERATING WEIGHT < 15 LBS.</p>
	<p>EXPANSION TANK:</p> <p>WATTS MODEL DETAS LEAD FREE EXPANSION TANK. TANK TO BE AS FOLLOWS:</p> <ul style="list-style-type: none"> ASME SECTION VIII CONSTRUCTION FDA APPROVED FIXED BUTYL BLADDER INTEGRAL BLADDER INTEGRITY MONITOR TANK TO BE 3.5 GALLONS WITH A 2.3 GALLON ACCEPTANCE VOLUME 3/4" INLET CONNECTION MAXIMUM OPERATING PRESSURE OF 150 PSIG MAXIMUM OPERATING WEIGHT = <40 LBS <p>SEE DETAIL 3-PS.1 FOR MOUNTING.</p>
	<p>TANKLESS ELECTRIC WATER HEATER:</p> <p>*CHRONOMITE* MICRO-LOW FLOW TANKLESS WATER HEATER, MODEL CM40L208 WITH DIGITAL MICRO PROCESSING TEMPERATURE CONTROL CAPABLE OF MAINTAINING OUTLET TEMPERATURE. WATER HEATER TO BE 8320 WATTS, 208V/1Ø, 40 AMPS. HEATER TO BE CAPABLE OF A TEMPERATURE RISE OF 57°F AT 1.0 GPM.</p> <p>UNIT WEIGHT = 5 LBS.</p> <p>SET OUTLET TEMPERATURE TO 105°F.</p>

©2023 Synthesis Partners, LLC All Rights Reserved
These record drawings have been prepared based upon information submitted, in part, by others. While this information is believed to be reliable, the Architect is not responsible for their accuracy, not for errors or omissions which may have been incorporated into these documents as a result.

PO Box 1900
Yuba City, CA 95992-1900
530.298.7298
www.spinc-arch.com

ARCHITECTURAL • COMMERCIAL • RESIDENTIAL • INTERIOR • CONSTRUCTION MANAGEMENT



SYNTHESIS PARTNERS, LLC
Managers • Architects


WESTON & ASSOCIATES
MECHANICAL ENGINEERS
601 UNIVERSITY AVE., SUITE 260 | SACRAMENTO, CA 95825
WESTON & ASSOCIATES 822-033

OWNER

Woodland Joint Unified School District
435 6th Street
Woodland, CA 95695

PROJECT
CLASSROOM CONVERSIONS
at
WOODLAND EDUCATION CENTER
575 Hays Street
Woodland, CA 95695

KEY PLAN

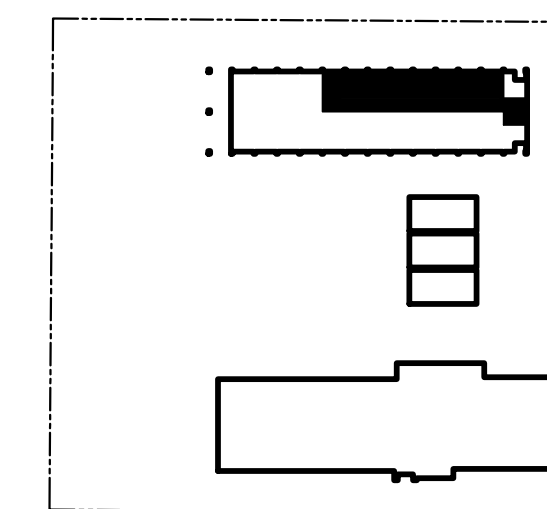


NO.	REVISION DESCRIPTION	DATE
1	ADDENDUM 2	2023/03/20

PLUMBING LEGEND & NOTES


DATE: 2022-07-24
PROJECT NO.: 21-W04-01

P0.1


Mar 30, 2023 - 10:11am / sgljic
 UNAUTHORIZED CHANGES & USES: M. Neils Engineering, Inc. Preparing these plans will not be responsible for, or liable for unauthorized changes to or uses to these plans. All changes to these plans must be in writing and must be approved by M. Neils Engineering, Inc.

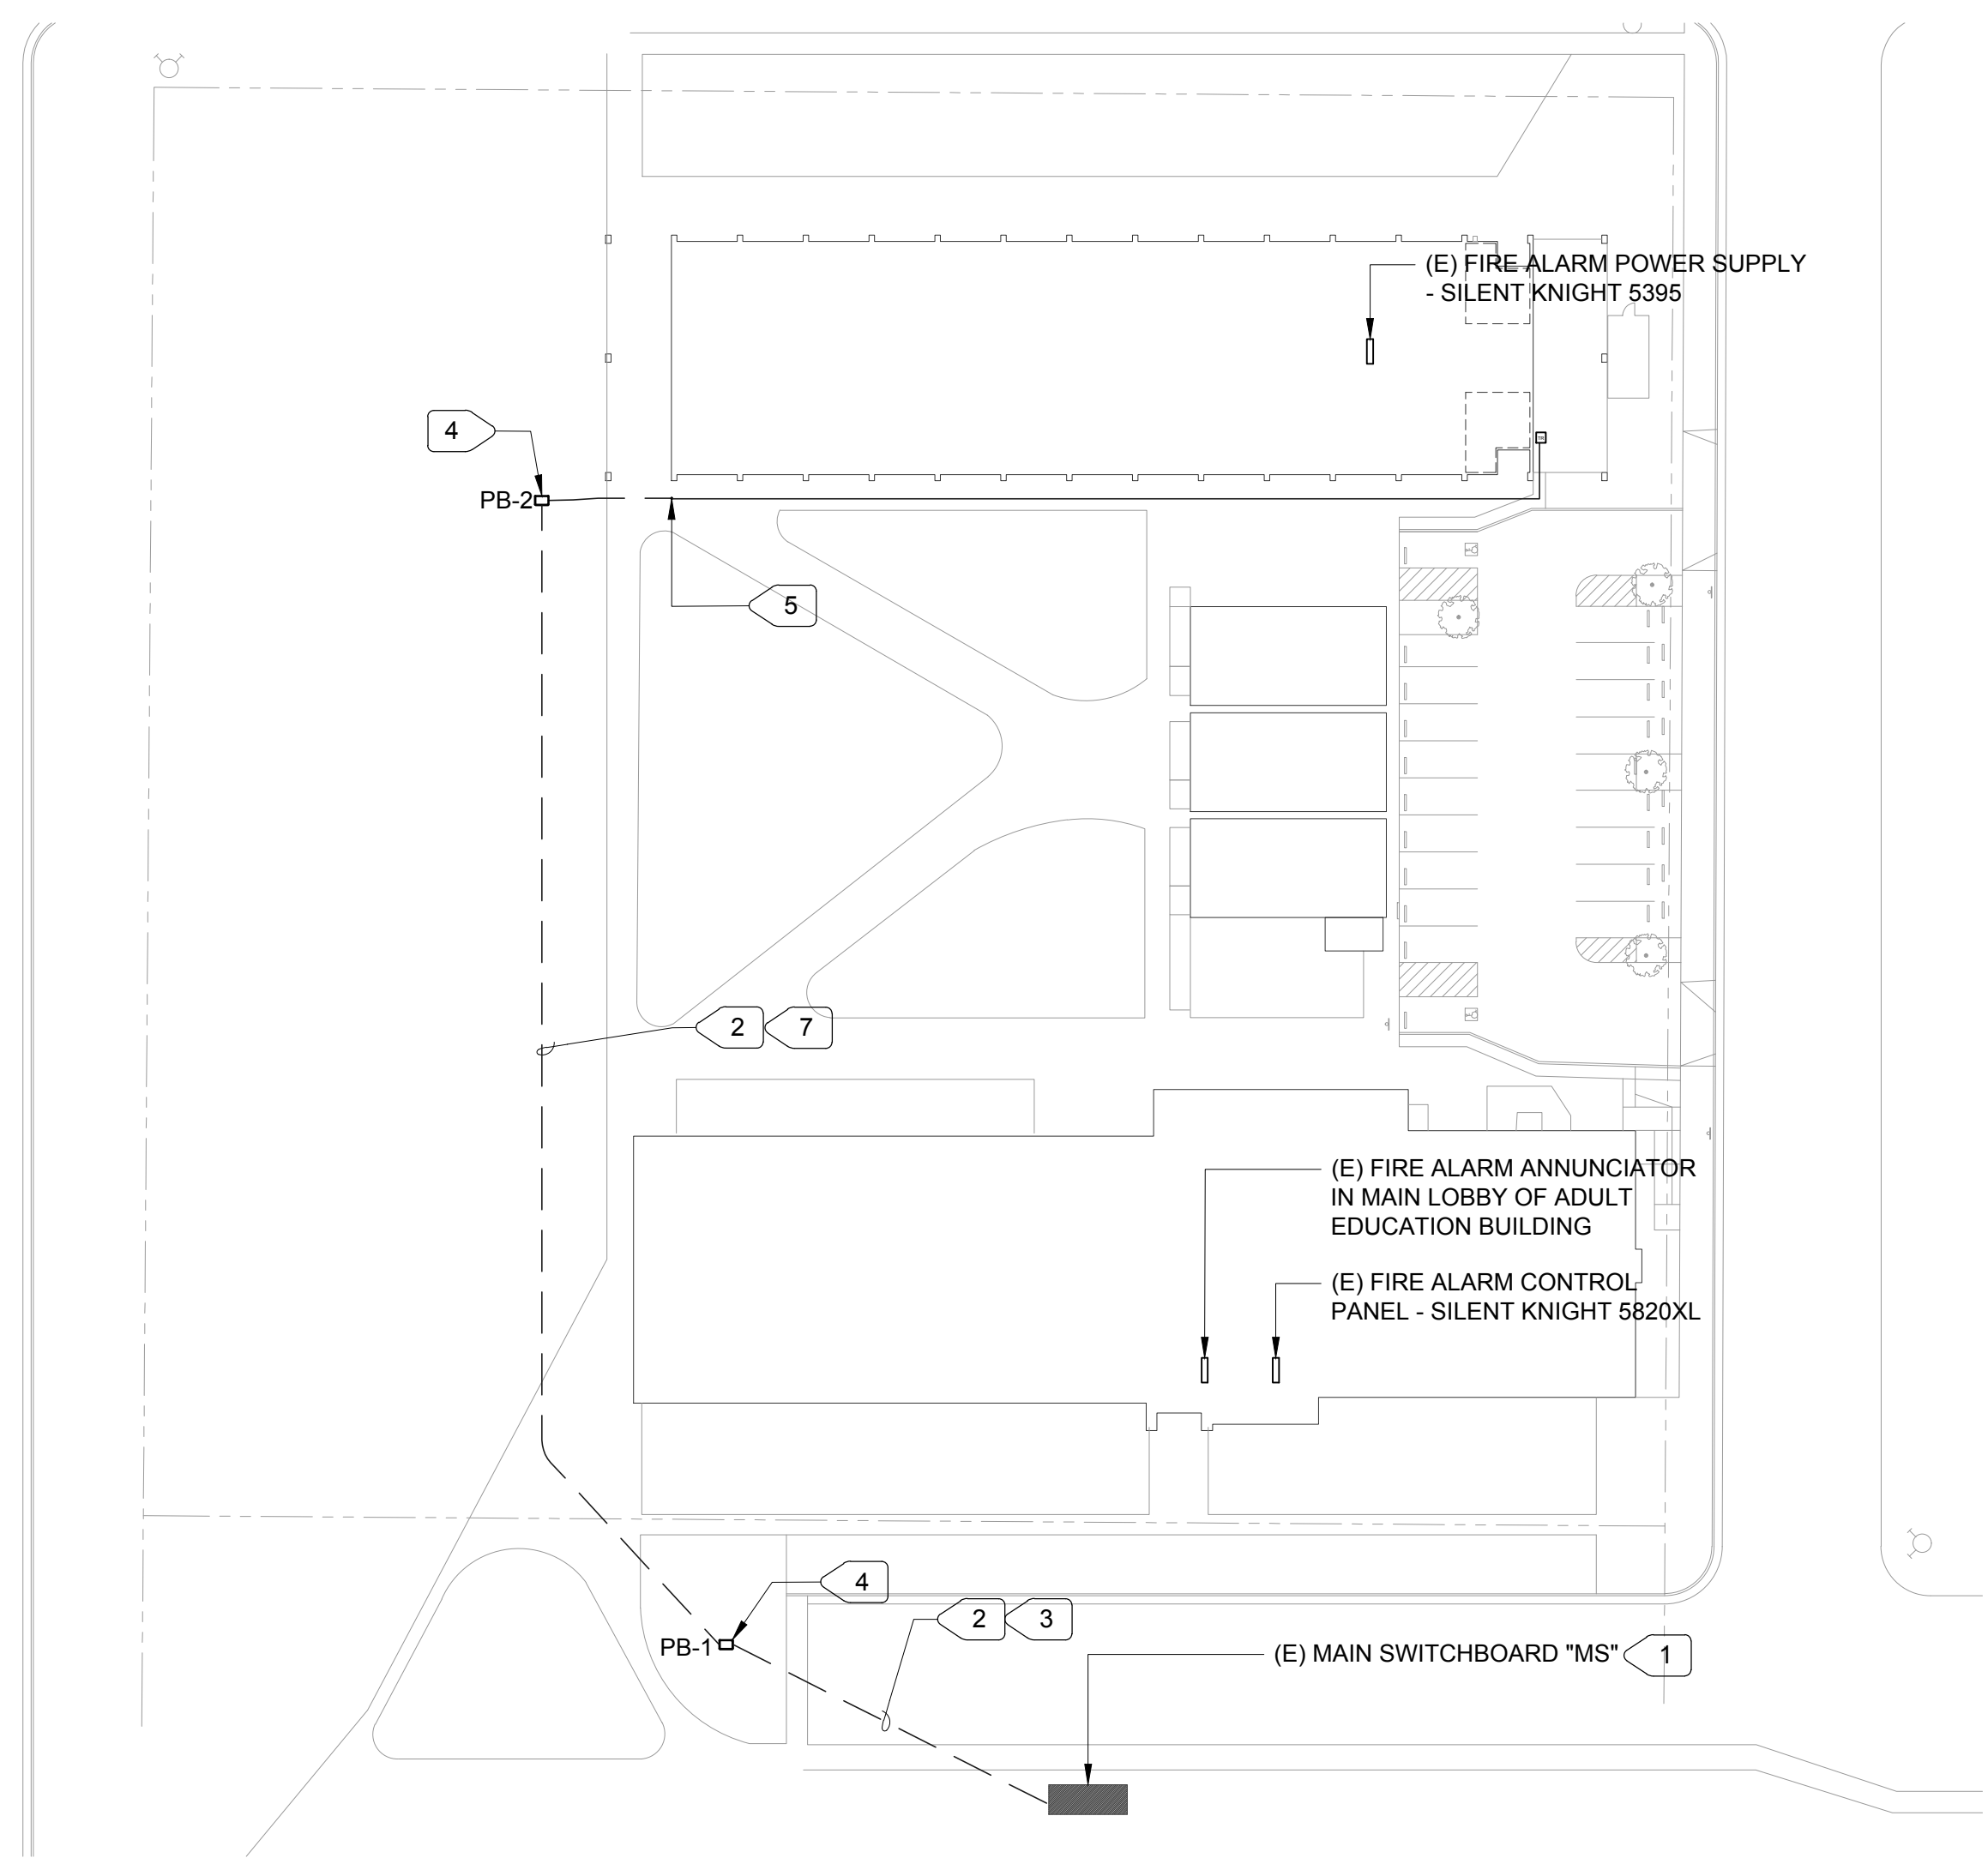

1 SITE PLAN - ELECTRICAL
E1.1 1" = 40'-0"

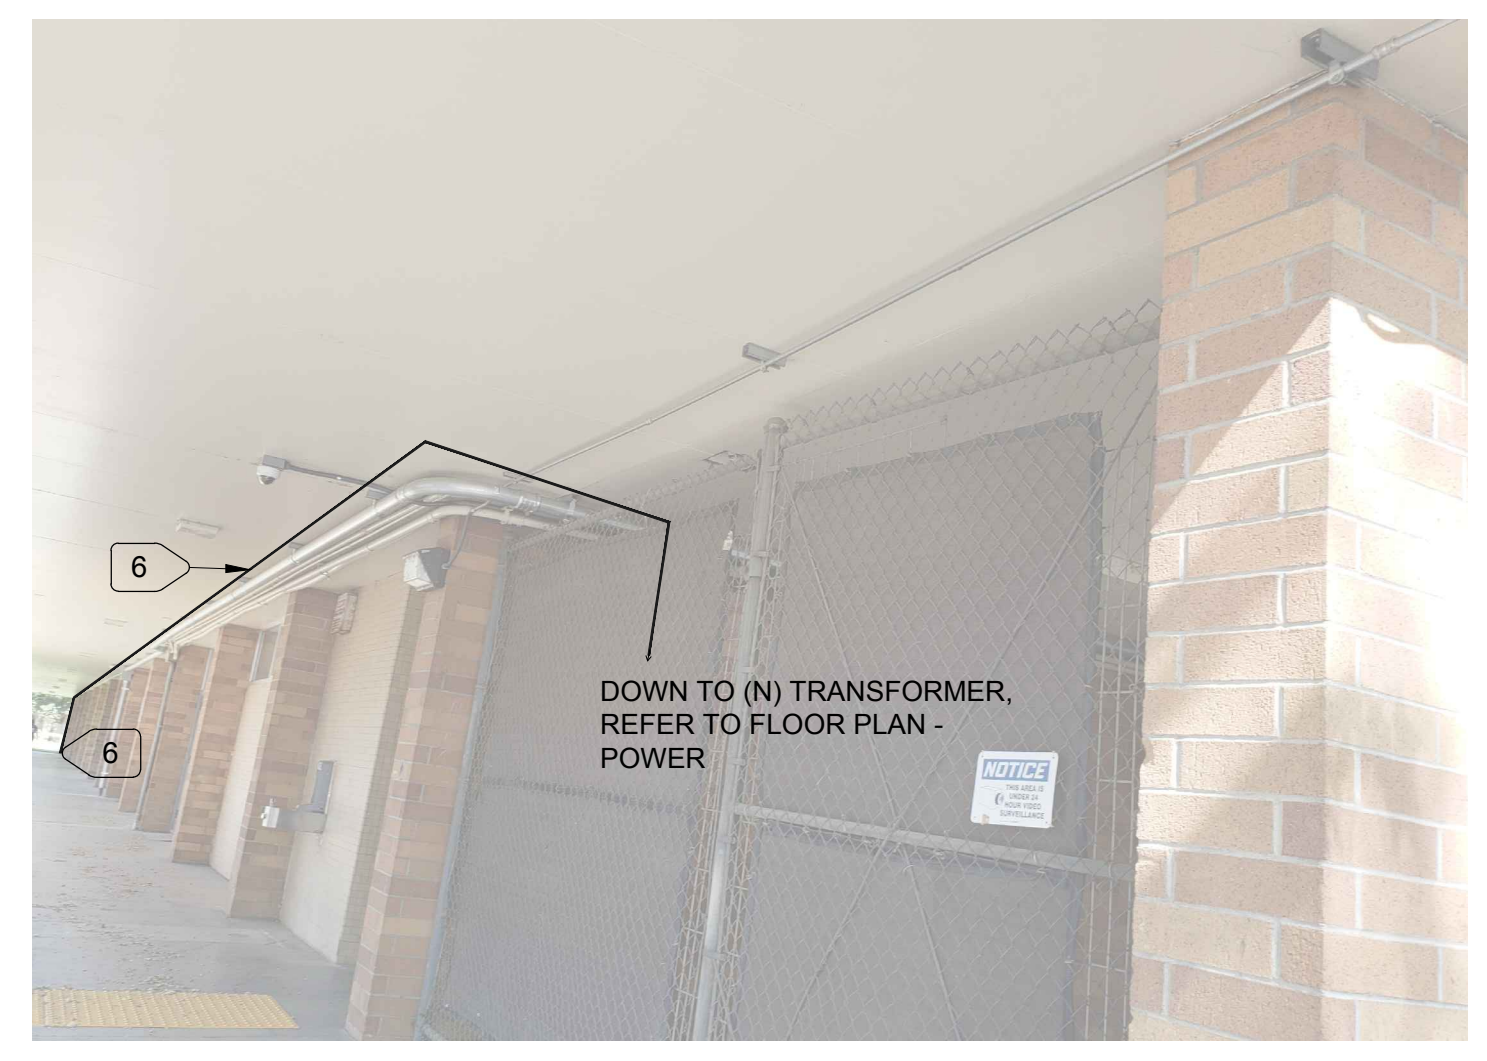

2 POWER CONDUIT RUN
E1.1 N.T.S.

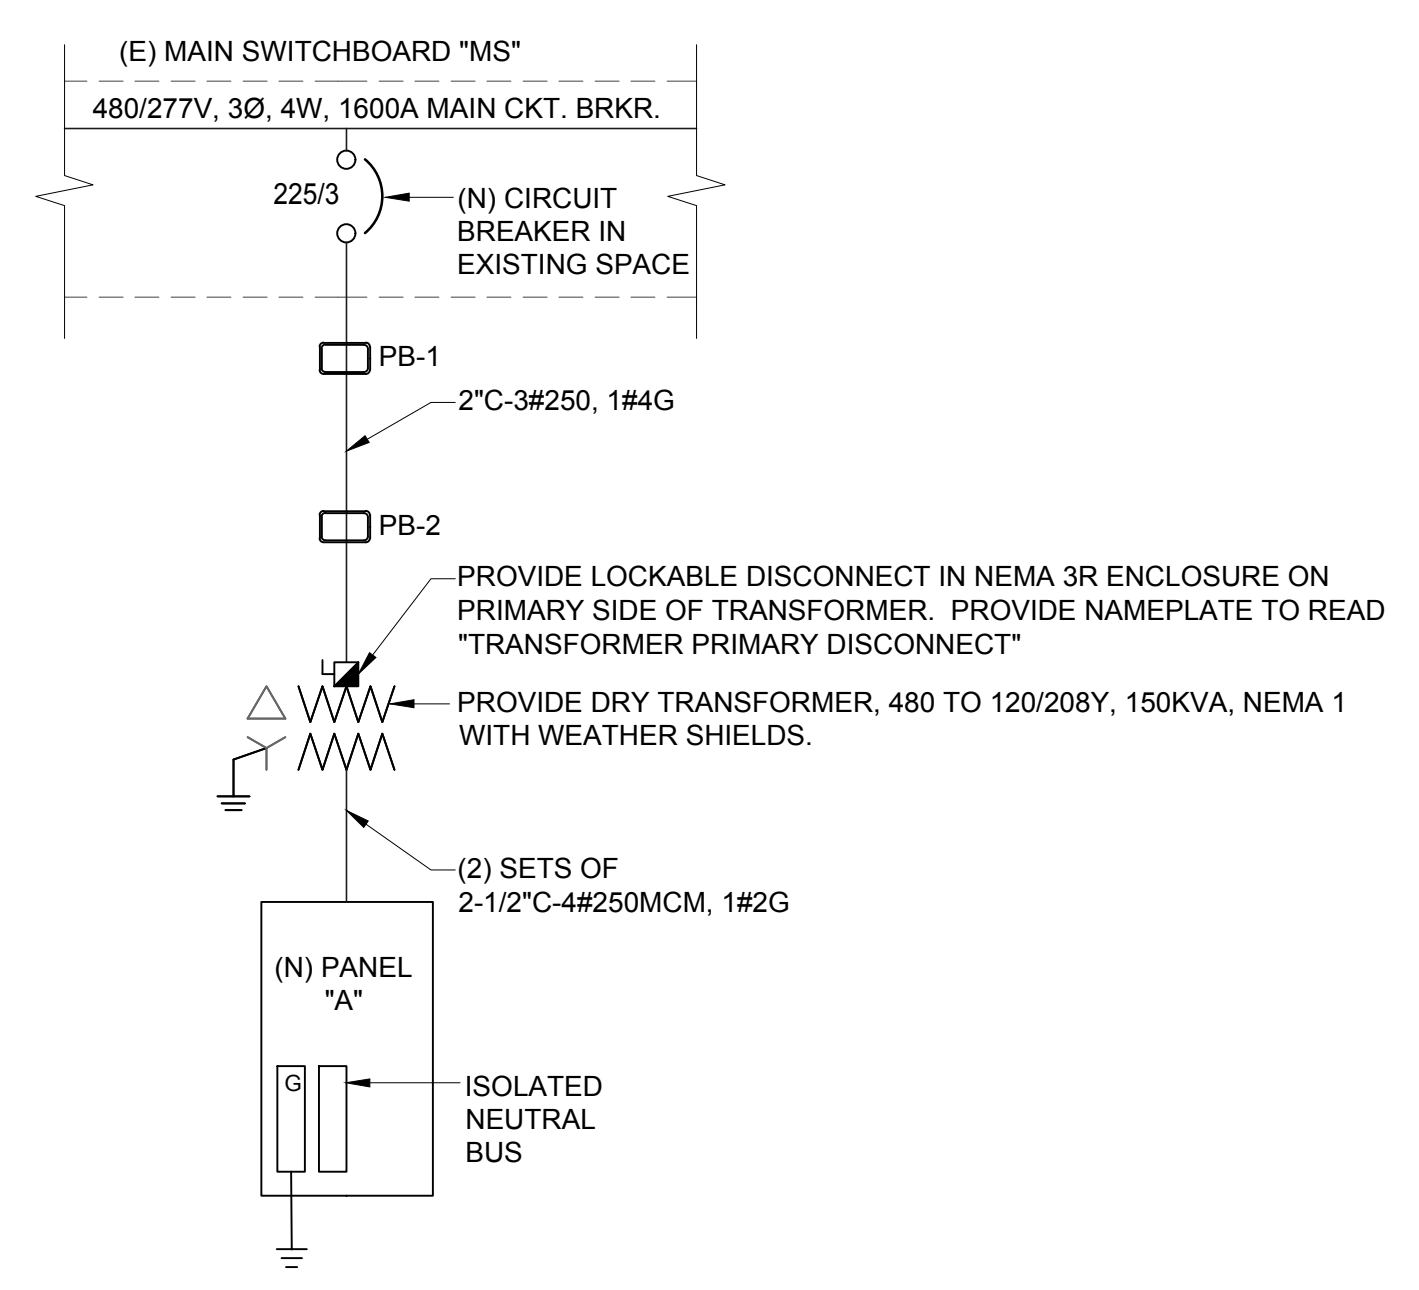

2 ONE LINE DIAGRAM - POWER
E1.1 N.T.S.

- NUMBERED NOTES:**
- 1 PROVIDE (N) CIRCUIT BREAKER IN (E) SPACE. REFER TO ONE LINE DIAGRAM - POWER.
 - 2 REFER TO ONE LINE DIAGRAM - POWER.
 - 3 DIRECTIONAL BORE.
 - 4 PROVIDE N40 PULLBOX, STEEL LID WITH HOLD-DOWN BOLTS AND (2) EXTENSION - SEE 3/E5.1.
 - 5 REFER TO BUILDING PHOTO BELOW FOR CONTINUATION.
 - 6 BRING (N) FEEDER UP COLUMN, AND CONTINUE RUN SIMILAR TO (E) CONDUITS. PROVIDE SUPPORT SIMILAR TO (E) CONDUIT SUPPORT.
 - 7 TRENCH PER 4/E5.1.

NEW PANEL "A" SCHEDULE

POWER SOURCE: MAIN SWITCHBOARD VIA TRANSFORMER "TR" LOCATION: SEE PLAN
 SYSTEM: NORMAL BRANCH

TYPE	BUS: 600 AMPS	MAIN BKR 500A	VOLTAGE: 208Y/120 VOLT, 3 PHASE, 4 WIRES			MOUNTING: SURFACE		REMARKS: 10k AIC MIN. SYMM.	
			CB	CKT	PHASE	CKT	PANEL TYPE NEMA 1		KVA
LOAD SERVED	KVA		CB	CKT	PHASE	CKT	CB	KVA	LOAD SERVED
RCPT - 104	0.8	20/1		1	A	2		7.0	
RCPT - 106	0.8	20/1		3	B	4	60/3	7.0	RANGE
CNC MILL	3.2	40/2		5	C	6		7.0	
RCPT - 106	0.8	20/1		7	A	8		7.0	
ROUTER	1.4	20/1		9	B	10	60/3	7.0	RANGE
ROUTER	1.4	20/1		11	C	12		7.0	
ROUTER	1.4	20/1		13	A	14		7.2	
ROUTER	1.4	20/1		15	B	16	75/3	7.2	OVEN
ROUTER	1.4	20/1		17	C	18		7.2	
SPARE		20/1		19	A	20	20/1	1.4	PROOFING CABINET
CNC MILL	3.2	40/2		21	B	22	20/2	5.15	RECEPTACLE PIZZA OVEN
CNC MILL	3.2	40/2		23	C	24		5.15	
CNC MILL	3.2	40/2		25	A	26		1.1	
SPARE		20/1		27	B	28	20/3	1.1	MIXER
SPARE		20/1		29	C	30		1.1	
CNC LATHE	3.2	40/2		31	A	32		1.1	
CNC LATHE	3.2	40/2		33	B	34	20/2	1.1	DOUGH SHEETER
CNC LATHE	3.2	40/2		35	C	36	20/1	0.6	RECEPT REFRIGERATOR
MANUFACTURING AIR COMPRESSOR	2.4	40/2		37	A	38	20/1	1.4	RECEPT FREEZER
DENTAL CHAIR	1.0	20/1		39	B	40	20/1	1.2	DISHWASHER
DENTAL CHAIR	1.0	20/1		41	C	42	20/1	1.5	ICE MACHINE
DENTAL CHAIR	1.0	20/1		43	A	44	20/1	0.6	RECEPT PREP TABLE
DENTAL CHAIR	1.0	20/1		45	B	46		0.7	
DENTAL CHAIR	1.0	20/1		47	C	48	20/3	0.7	KEF-1
MAU-1	1.4	20/3		49	A	50		0.7	
MAU-1	1.4	20/3		51	B	52	20/1		LIGHT EXHAUST HOOD
MAU-1	1.4	20/3		53	C	54	20/1	0.2	KEF-2
COCOON	0.5	20/1		55	A	56	20/1	0.4	RECEPT MEAT SLICER
DENTAL CAMERA	0.5	20/1		57	B	58	20/1	0.7	RECEPT MIXER
DENTAL VACUUM	1.1	15/2		59	C	60	20/1	1.5	RECEPT MIXER
DENTAL VACUUM	1.1	15/2		61	A	62	20/1	1.8	RCPT TOP STOVE BURNER
DENTAL AUTCLAVE	1.5	20/1		63	B	64	20/1	1.8	RCPT TOP STOVE BURNER
DENTAL AIR COMPRESSOR	0.5	20/2		65	C	66	20/1	1.8	RCPT TOP STOVE BURNER
DENTAL AIR COMPRESSOR	0.5	20/2		67	A	68	20/1	1.8	RCPT TOP STOVE BURNER
XRAY	1.2	20/1		69	B	70	20/1	0.8	RCPT FOOD PROCESSOR
XRAY	1.2	20/1		71	C	72	20/1	1.7	RECEPT MICROWAVE
DENTAL AUTCLAVE	1.5	20/1		73	A	74	20/1	1.8	RECEPT TOASTER
GWH-1/CP-1	0.3	20/1		75	B	76	20/1 [1]	0.5	FIRE SUPPRESSION SYST.
GAS SHUTDOWN	0.3	20/1		77	C	78	20/1	0.5	SHUNT TRIP POWER
IWH-1	3.1	40/2		79	A	80	PFB		SPACE
IWH-1	3.1	40/2		81	B	82	PFB		SPACE
SPACE				83	C	84	PFB		SPACE

NOTES:
 [1] PROVIDE WITH RED HANDEL AND LOCKING DEVICE

CONNECTED LOAD
 PHASE A= 57.3 kVA
 PHASE B= 58.2 kVA
 PHASE C= 56.1 kVA
 TOTAL = 171.6 kVA
 TOTAL = 476.7 Amperes

©2023 Synthesis Partners, LLC. All Rights Reserved. These record drawings have been prepared based upon information submitted, in part, by others. While this information is believed to be reliable, the Architect is not responsible for their accuracy, nor for errors or omissions which may have been incorporated into these documents as a result.

PO Box 1900
 Yuba City, CA 95992-1900
 530.298.7298
 www.spinc-arch.com

ARCHITECTURAL • COMMERCIAL • RESIDENTIAL • INTERIOR • CONSTRUCTION MANAGEMENT




SYNTHESIS PARTNERS, LLC
Managers • Architects

M. NEILS ENGINEERING, INC.
 Electrical Engineers | Lighting Designers
 100 Howe Ave., Suite 235N
 Sacramento, CA 95825-8217
 www.mneilsengineering.com
 Tel: (916) 923-4400 Fax: (916) 923-4410
 PROJECT #: 22133.21

OWNER
 Woodland Joint Unified School District
 435 6th Street
 Woodland, CA 95695

PROJECT
 CLASSROOM CONVERSIONS
 at
 WOODLAND EDUCATION CENTER
 575 Hays Street
 Woodland, CA 95695

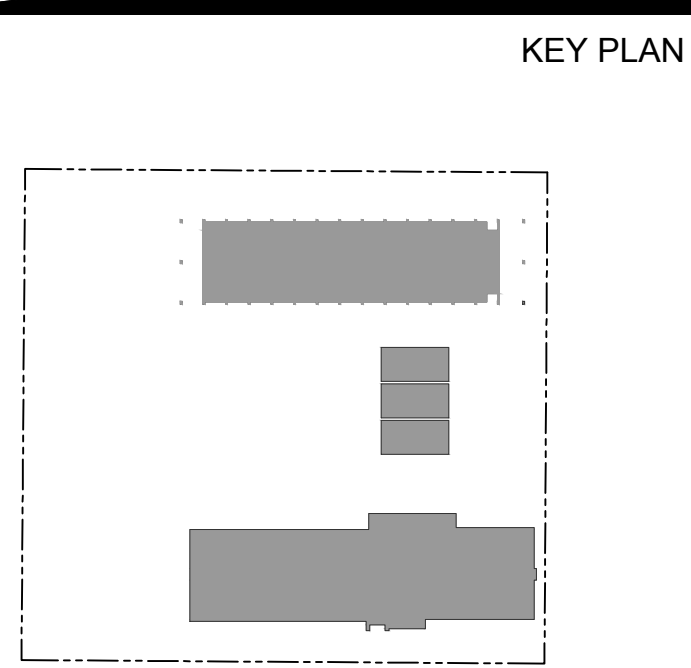

KEY PLAN



NO.	REVISION DESCRIPTION	DATE

SITE PLAN - ELECTRICAL ONE LINE DIAGRAM, PANEL SCHEDULE

DATE: 2022-07-29
 PROJECT NO.: 21-W04-01

E1.1